SURVEY &
REMONUMENTATION

MAY 0 3 1995

COMMISSION

LAND CORNER RECORDATION CERTIFICATE

Filing Requirement of Act 74, Mich. P.A. 1970

For corners in

OGEMAW
(County)

	Located In:	Corner Code #
1. Public Land Survey	T 23N R 3E	M-7
	T ___ R ___	
	T ___ R ___	
	T ___ R ___	
2. Property Controlling	S ___ T ___ R ___	Seg #1
in Section	S ___ T ___ R ___	
3. Miscellaneous	S ___ T ___ R ___	
Property in Sec.	S ___ T ___ R ___	

LIBER 2 PAGE 266
STATE OF MICHIGAN
OGEMAW COUNTY
RECORDED

3 JAN 95 9:36 A.M.

WANDA MUZIK
REGISTER OF DEEDS

Register of Deeds Stamp & File Number

4. Lot No. _____, Recorded Plat _____
5. Private Claims _____

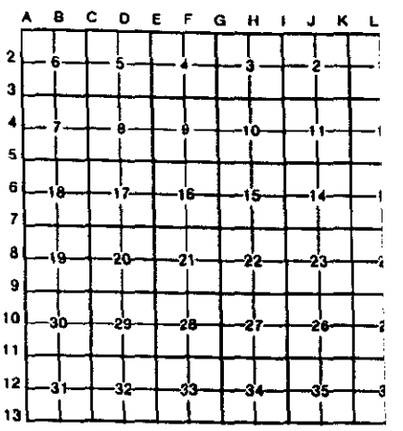

I, Timothy L. Lapham, in a field survey on December, 19 94, do hereby certify that under requirements of P.A. 74, Michigan P.A. of 1970, the corner points mentioned in lines 1 and 2 above were in conformance with regulations and rules therefore as required in the current manual of survey instructions of the United States Department of the Interior, Bureau of Land Management or by a decree of a Court of Law and/or that the corner points mentioned in lines 3, 4 and 5 above were in conformance with the rules of the Michigan Board of Land Surveyors or by a Decree of a Court of Law; established, re-established, monumented, re-monumented, recovered, found as expressed below:

NOTE: Not more than 4 corners, all in the same town and range, may be recorded on this certificate.

A. Description of original monument and accessories and/or subsequent restoration:

M-7: CLASON 1838, SET POST, LEANING HEMLOCK 20" S49W 14L.
LEANING HEMLOCK 18" N45W 51L.
KING SURVEY 4-65*72, 10/30/1986, FD IRON, 4 WITS
KING LCRC 2-125, 12/02/1991, SAME AS 4-65*72
KING SURVEY 5-128*135, 9/09/1991, REVISION OF 4-65*72 NO CORNER CHANGE

B. Description of corner evidence found and/or method applied in restoring or reestablishing corner:

M-7: FOUND 1/2" IRON IN CENTERLINE ROAD N-S AND ON N EDGE OF GRAVEL SURFACE EAST IN ACCORD WI
PREVIOUS SURVEYS AND LCRC, GLO STREAM CALL TO NORTH 0.5+/- CHAIN SHORT, BUT CORNER MATCHE
LOCAL FENCE AND APPEARS TO HAVE BEEN ACCEPTED BY RESIDENTS,
ACCEPTED FOUND CORNER AS BEST AVAILABLE EVIDENCE OF CORRECT CORNER POSITION
CORNER APPROVED BY PEER REVIEW MEETING HELD DECEMBER 21, 1994.
SEE DOSSIER FOR ADDITIONAL INFORMATION

APPROVED BY
PEER REVIEW
12-21-94
DATE P.A. 345 of 1990

C. Description of monument for corner and accessories established to perpetuate locating the position of the corner:

M-7: SET 5/8"x36" REROD WITH 3-1/4" AL. OGEMAW REMON CAP
N69E 51.41' FD NAIL IN POWER POLE
S53E 61.15' SET NAIL IN 20" WHITE PINE (PREVIOUS WITNESS APPEARS TO HAVE BEEN TO FACE
BASE OF TREE)
S24W 89.80' SET NAIL IN 12" WHITE PINE
N39W 46.33' 1/2" CAPPED IRON #25852

STATE OF MICHIGAN
TIMOTHY L. LAPHAM
PROFESSIONAL SURVEYOR
NO. 27595
PROFESSIONAL SURVEYOR

Signed by _____ Date 12/27/94

Surveyor's Michigan License No. 27595

FORM APPROVED BY MICHIGAN STATE BOARD OF LAND SURVEYORS. JAN. 28.
REVISED MAY 14.
REVISED JAN.