

**SURVEY &
REMONUMENTATION**

Attach to: T 23N R 4E A-8 Seg #1 MRD

MAY 03 1995

COMMISSION

LAND CORNER RECORDATION CERTIFICATE
Filing Requirement of Act 74, Mich. P.A. 1970

For corners in
OGEMAW

LIBER

2 PAGE 267

STATE OF MICHIGAN
OGEMAW COUNTY
RECORDED

3 JAN 95 9:38 A.M.

WANDA MUZIK
REGISTER OF DEEDS

Register of Deeds Stamp & File Number

	Located In:	Corner Code ##
1. Public Land Survey	T 23N R 3E	M-8
	T _____ R _____	_____
	T _____ R _____	_____
	T _____ R _____	_____
2. Property Controlling in Section	S _____ T _____ R _____	Seg. #1
	S _____ T _____ R _____	_____
3. Miscellaneous Property in Sec.	S _____ T _____ R _____	_____
	S _____ T _____ R _____	_____
4. Lot No. _____, Recorded Plat _____		
5. Private Claims _____		

I, Timothy L. Lapham, in a field survey on December, 1994, do hereby certify that under requirements of P.A. 74, Michigan P.A. of 1970, the corner points mentioned in lines 1 and 2 above were in conformance with regulations and rules therefore as required in the current manual of survey instructions of the United States Department of the Interior, Bureau of Land Management or by a decree of a Court of Law and/or that the corner points mentioned in lines 3, 4 and 5 above were in conformance with the rules of the Michigan Board of Land Surveyors or by a Decree of a Court of Law; established, re-established, monumented, re-monumented, recovered, found as expressed below:

NOTE: Not more than 4 corners, all in the same town and range, may be recorded on this certificate.

A. Description of original monument and accessories and/or subsequent restoration:
M-8: CLASON 1838, SET POST, W.PINE 24" S74W 20L., W.PINE 16" N66W 16L.
KING SURVEY 4-65*72, 10/30/1986, FD IRON AND CAP, 4 WITS
KING LCRC 2-126, 12/02/1991, SAME AS 4-65*72
KING SURVEY 5-128*135, 9/09/1991, REVISION OF 4-65*72 NO CORNER CHANGE


B. Description of corner evidence found and/or method applied in restoring or reestablishing corner:
M-8: FOUND 1/2" IRON AND CAP WITH WITNESSES THAT VERIFY THAT THIS IS CORNER OF RECORD BY KING SWAMP EDGES INDISTINCT BUT APPROXIMATELY MATCH GLO EXISTING FENCE AND ROAD LOCATION AGREE WITH FOUND CORNER ACCEPTED FOUND CORNER AS BEST EVIDENCE OF ORIGINAL CORNER POSITION CORNER APPROVED AT PEER REVIEW MEETING HELD ON DECEMBER 21, 1994. SEE REMON DOSSIER FOR ADDITIONAL INFORMATION.

C. Description of monument for corner and accessories established to perpetuate locating the position of the corner:
M-8: SET 5/8"x36" REROD WITH 3-1/4" STANDARD REMON AL. CAP
N34E 34.75' FD NAIL IN 16" MAPLE
N70E 21.22' FD NAIL IN 14" MAPLE
S31E 51.09' FD NAIL IN 10" RED PINE
S21W 56.94' FD NAIL IN 30" MAPLE
N87W 32.07' SET NAIL IN FENCE POST
EAST 3' CENTERLINE WILTSE ROAD

APPROVED BY
PEER REVIEW
12-21-94 TL
DATE P.A. 345 of 1990

Signed by [Signature]
Surveyor's Michigan License No. 27595

Date 12/29/94

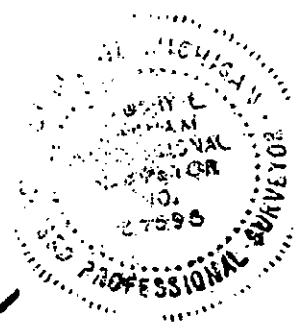

SURVEY & REMONUMENTATION

MAY 05 1997

LAND CORNER RECORDATION CERTIFICATE
Filing Requirement of Act 74, Mich. P.A. 1970

For corners in **COMMISSION**
OGEMAW

	Located In:	Corner Code #
1. Public Land Survey	T 23N R 4E	A-7
	T 23N R 4E	A-8 ✓
	T 23N R 4E	A-9
	T 23N R 3E	M-7 AS 1/7/99
2. Property Controlling in Section	S T 23N R 3E	M-8 AS 1/7/99
	S T 23N R 3E	M-9 AS 1/7/99
3. Miscellaneous Property in Sec.	S T R	
	S T R	
4. Lot No. _____, Recorded Plat _____		
5. Private Claims _____		

LICER 3 PAGE 03

STATE OF MICHIGAN
 Ogemaw County
 RECORDED

20 APR 95 10:20 A.M.

Register of Deeds Stamp & Fee Number
 HANNA HUZIK
 REGISTER OF DEEDS

I, Timothy L. Lapham, in a field survey on December, 19 94, do hereby certify that under requirements of P.A. 74, Michigan P.A. of 1970, the corner points mentioned in lines 1 and 2 above were in conformance with regulations and rules therefore as required in the current manual of survey instructions of the United States Department of the Interior, Bureau of Land Management or by a decree of a Court of Law and/or that the corner points mentioned in lines 3, 4 and 5 above were in conformance with the rules of the Michigan Board of Land Surveyors or by a Decree of a Court of Law; established, re-established, monumented, re-monumented, recovered, found as expressed below:

NOTE: Not more than 4 corners, all in the same town and range, may be recorded on this certificate.

	A	B	C	D	E	F	G	H	I	J	K	L
2	6	5	4	3	2							
3												
4	7	8	9	10	11	12						
5												
6	16	17	18	15	14	13						
7												
8	19	20	21	22	23	24						
9												
10	30	29	28	27	26	25						
11												
12	31	32	33	34	35	36						
13												

- A. Description of original monument and accessories and/or subsequent restoration:**
 A-7: COMMON CORNER WITH M-7, T23N, R3E, SEE LCRC FOR THAT CORNER AND REMONUMENTATION DOSSIER FOR ADDITIONAL INFORMATION. CORNER APPROVED AT PEER REVIEW MEETING HELD ON DEC 21, 1994
 A-8: COMMON CORNER WITH M-8, T23N, R3E, SEE LCRC FOR THAT CORNER AND REMONUMENTATION DOSSIER FOR ADDITIONAL INFORMATION. CORNER APPROVED AT PEER REVIEW MEETING HELD ON DEC 21, 1994
 A-9: COMMON CORNER WITH M-9, T23N, R3E, SEE LCRC FOR THAT CORNER AND REMONUMENTATION DOSSIER FOR ADDITIONAL INFORMATION. CORNER APPROVED AT PEER REVIEW MEETING HELD ON DEC 21, 1994

- B. Description of corner evidence found and/or method applied in restoring or reestablishing corner:**
 A-7: COMMON CORNER WITH M-7, T23N, R3E, SEE LCRC FOR THAT CORNER AND REMONUMENTATION DOSSIER FOR ADDITIONAL INFORMATION.
 A-8: COMMON CORNER WITH M-8, T23N, R3E, SEE LCRC FOR THAT CORNER AND REMONUMENTATION DOSSIE FOR ADDITIONAL INFORMATION.
 A-9: COMMON CORNER WITH M-9, T23N, R3E, SEE LCRC FOR THAT CORNER AND REMONUMENTATION DOSSIE FOR ADDITIONAL INFORMATION.

- C. Description of monument for corner and accessories established to perpetuate locating the position of the corner:**
 A-7: COMMON CORNER WITH M-7, T23N, R3E, SEE LCRC FOR THAT CORNER AND REMONUMENTATION DOSSIER FOR ADDITIONAL INFORMATION.
 A-8: COMMON CORNER WITH M-8, T23N, R3E, SEE LCRC FOR THAT CORNER AND REMONUMENTATION DOSSIE FOR ADDITIONAL INFORMATION.
 A-9: COMMON CORNER WITH M-9, T23N, R3E, SEE LCRC FOR THAT CORNER AND REMONUMENTATION DOSSIE FOR ADDITIONAL INFORMATION.

Signed by [Signature]

Date 4-20-95

Surveyor's Michigan License No. 27595