

APR 08 1999

Ogemaw County Remonumentation

LAND CORNER RECORDATION CERTIFICATE  
Filing Requirement of Act 74, Mich. P.A. 1970

SECTION

For corners in

_____ Ogemaw _____ (County)	Located in:	Corner Code #
1. Public Land Survey	T23N R04E	K-10
	T _____ R _____	_____
	T _____ R _____	_____
	T _____ R _____	_____
2. Property Controlling in Section	S _____ T _____ R _____	_____
	S _____ T _____ R _____	_____
3. Miscellaneous Property in Sec.	S _____ T _____ R _____	_____
	S _____ T _____ R _____	_____

LIBER 3 PAGE 212  
STATE OF MICHIGAN  
OGEMAW COUNTY  
RECORDED  
23 DEC 1998 3:48:39 PM  
WANDA MUZIK  
REGISTER OF DEEDS

Register of Deeds Stamp & File Number

4. Lot No. \_\_\_\_\_, Recorded Plat \_\_\_\_\_  
5. Private Claims \_\_\_\_\_

I, Timothy L Lapham, in a field survey on December, 19 98, do hereby state that under requirements of P.A. 74, Michigan P.A. of 1970, the corner points mention in lines 1 and 2 above were in conformance with regulations and rules therefore as required in the current manual of survey instructions of the United States Department of the Interior, Bureau of Land Management or by a decree of a Court of Law and/or that the corner points mentioned in lines 3, 4 and 5 above were in conformance with the rules of the Michigan Board of Land Surveyors or by a Decree of a Court of Law; established, re-established, monumented, recovered, found as expressed below:

	A	B	C	D	E	F	G	H	I	J	K	L
1												
2	6		5		4		3		2		1	
3												
4	7		8		9		10		11		12	
5												
6	18		17		16		15		14		13	
7												
8	19		20		21		22		23		24	
9												
10	30		29		28		27		26		25	
11												
12	31		32		33		34		35		36	
13												

NOTE: Not more than 2 corners, all in the same town and range, may be recorded on this certificate

A. Description of original monument and accessories and/or subsequent restoration:

**K-10:** GLO 12/27/1844 J. Mullett set post  
B. Oak 16" S73E 20 lk  
Maple 8" S7W 19 lk  
SECTION break 1970 N. Caldwell, set RR spike  
no witnesses, meas 2617.5 to K-9 and K-11  
angle on east side of line = 179-27-25  
LCRC 1-348 7/19/1986 T.Lapham  
set 1/2" capped iron SPM  
N65W 48.92 12" poplar  
S70W 53.82 8" Maple  
S80E 62.04 18" ash  
W 14' centerline of road  
SURVEY unrec 10/23/1986 T. Lapham  
cor and wits same as LCRC 1-348  
dist to K-9 = 2618.14  
SURVEY unrec 10/27/1986 T.Lapham  
cor and wits same as LCRC 1-348  
dist to K-9 = 2618.14  
SURVEY unrec 8/23/1988 T.Lapham  
cor and wits same as LCRC 1-348  
dist to K-9 = 2618.22  
SURVEY unrec 10/16/1991 T.Lapham  
cor and wits same as LCRC 1-348  
dist to K-9 & K-11 = 2617.93

B. Description of corner evidence found and/or method applied in restoring or reestablishing corner:


**K-10:** No evidence of GLO corner or witnesses. An iron was set in 1970 at the centerline of road midway between K-9 and K-11. This is incorrect procedure. This iron was destroyed. The corner was reset in 1986 by SPM. The road was rebuilt on SPM position in 1997. During construction the iron was again removed and all witnesses destroyed. The position was reset by SPM between K-9 and K-11. This position was accepted as the best available evidence of the correct position of the corner.

C. Description of monument for corner and accessories established to perpetuate locating the position of the corner:

**K-10:** Set 5/8"x36" rod with aluminum Ogemaw county remon. cap with witnesses:  
N66W 82.73 spike in 12" birch  
S89E 33.33 spike in fence corner post  
S42E 54.12 spike in 18" twin poplar  
S76W 79.95 spike in 12" cedar

Approved by Peer Review

12/15/98 DATE INITIALS

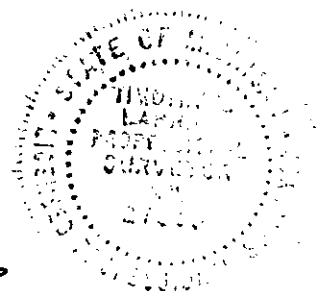

Signed by [Signature]  
Surveyor's Michigan License No. 27595

Date 12/23/98