

**LAND CORNER RECORDATION CERTIFICATE**  
**Filing Requirement of Act 74, Mich. P.A. 1970**

For corners in  
OBEMAN  
 (County)

Located In: \_\_\_\_\_ Corner Code ##

1. Public Land Survey	T <u>21N</u> R <u>1E</u>	<u>L-13, M-13</u>
	T _____ R _____	_____
	T _____ R _____	_____
	T _____ R _____	_____
2. Property Controlling in Section	S <u>36</u> T _____ R _____	<u>16</u>
	S _____ T _____ R _____	_____
3. Miscellaneous Property in Sec.	S _____ T _____ R _____	_____
	S _____ T _____ R _____	_____

Register of Deeds Stamp & File Number

4. Lot No. \_\_\_\_\_, Recorded Plat \_\_\_\_\_  
 5. Private Claims \_\_\_\_\_

A	B	C	D	E	F	G	H	I	J	K	L	M
2	6	5	4	3	2	1						
3												
4	7	8	9	10	11	12						
5												
6	18	17	16	15	14	13						
7												
8	19	20	21	22	23	24						
9												
10	30	29	28	27	26	25						
11												
12	31	32	33	34	35	36						
13												

I, CARL F. ROSER, in a field survey on OCTOBER 26, 19 93, do hereby certify that under requirements of P.A. 74, Michigan P.A. of 1970, the corner points mentioned in lines 1 and 2 above were in conformance with regulations and rules therefore as required in the current manual of survey instructions of the United States Department of the Interior, Bureau of Land Management or by a decree of a Court of Law and/or that the corner points mentioned in lines 3, 4 and 5 above were in conformance with the rules of the Michigan Board of Land Surveyors or by a Decree of a Court of Law; established, re-established, monumented, re-monumented, recovered, found as expressed below:

**NOTE: Not more than 4 corners, all in the same town and range, may be recorded on this certificate.**

A. Description of original monument and accessories and/or subsequent restoration:  
 L-13 M-13 16

(NO EVIDENCE OF G.L.O. CORNER, B.T.'S, LINE TREES & TOPOGRAPHY, AS CALLED OUT IN THE G.L.O. LINE NOTES; UNLESS NOTED IN ITEM "B" BELOW.)

B. CONT: COR(NE COR S-5), FROM SOUTH (RUN-OUT SEC.), 33.5 CH'S. OLD B-WIRE FN REMAINS (N'LY 1/2 MI.) 40'± E. E-W B.WIRE IS 10' S.

B. CONT- ESTAB. MEANINGFUL CONTROL ALONG SAID CORR LINE. CALC. E1/8 ON N. LINE SEC 5, NOTHING SET THIS SURVEY, WOULD BE N88°11'25"E, 214.24'. COR OF OLD & NEW FN N'LY & W'LY (FN'S N'LY WIND AROUND) IS 5'± E & 21'± N.

B. Description of corner evidence found and/or method applied in restoring or reestablishing corner:  
 L-13 M-13 16

REESTABLISHED S 1/4 COR S-36 MIDWAY & ON LINE BETWEEN FD SW COR S-36 & REESTABLISHED SE COR S-36. CTR OF E-W DITCH IS 56'± SOUTH. CTR OF DITCH TO WEST IS 40'± N. CTR OF DITCH TO NORTH IS 10'± WEST. B.WIRE FN E'LY IS 21'± NORTH.

RESTORED TWP. COR, ON MICH 2ND CORR. LINE, TWP COR TO SE COR OF S-36, T21N-R1E AND SW COR OF S-31, T21N-R2E, OBEMAN CO; BY DBL PROP TO US G.L.O. (GEN. LAND OFFICE) SURVEY FOR 1-MILE EAST (GLO, ORIG = 87 CH'S, BUT THEY BOOED IT, SO USED 82 CH'S FOR P.M.), 1-MILE W. (GLO = 80 CH'S), 1/2 MILE N. (GLO = 40 CH'S) AND OFF-SET DISTANCE TO EAST TO CLOSING-CONT. ABOVE


ESTABLISHED SW COR OF E 1/2 OF SE 1/4 S-36 PER STANDARD BLM INSTRUCTIONS. OLD LEANING FENCE COR (B.WIRE N & E) IS 9'± S & 3'± W. THOUGH THIS IS NOT A B'DRY BETWEEN STATE AND PVT, AND SINCE IT WAS NECESSARY TO RUN CONTROL TRV. ALL THE WAY WEST TO M-30, PLUS BEING CONTROL ON MICH 2ND CORR LINE, IT SEEMED IMPORTANT TO THIS SURVEYOR TO -CONT ABOVE-

C. Description of monument for corner and accessories established to perpetuate locating the position of the corner:

L-13 SET DNR MON & CED POST.  
 23° W PINE S50°E 60.11'  
 7° SPRUCE S10°E 43.15'  
 4° ELM N85°W 56.88'  
 DNR MON, N 1/4 S-5  
 T20N-R2E N88°11'E 187.29'

M-13 SET DNR MON & CED POST.  
 3° MAPLE N60°W 23.89'  
 4° ASH N35°W 17.19'  
 5° OAK N65°E 36.20'  
 9° MAPLE S85°E 25.22'  
 DNR MON, NE S-5  
 T20N-R2E N88°06'E 241.20'  
 E-W WINDING TRAIL (FROM N) IS NORTH 34'

16 DROVE 5/8" X 34" REROD W/RLS CAP. SET CED POST W/LOC TAG.  
 4° MAPLE N30 W 3.68'  
 4° TRPL MAPLE S35 E 32.60'  
 6° TW MAPLE S10 E 35.71'  
 13° CEDAR S65 W 63.80'

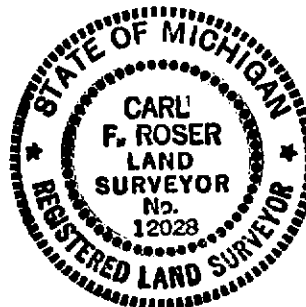

Signed by Carl F. Roser 12028 Date 6-20-95