

LAND CORNER RECORDATION CERTIFICATE
Filing Requirement of Act 74, Mich. P.A. 1970

For corners in
OGEMAN
 (County)

Located In: _____ Corner Code #

- | | | | | | |
|------------------------------------|---|------------|---|-----------|-------------------|
| 1. Public Land Survey | T | <u>21N</u> | R | <u>1E</u> | <u>K-11, K-13</u> |
| | T | _____ | R | _____ | <u>L-11</u> |
| | T | _____ | R | _____ | _____ |
| | T | _____ | R | _____ | _____ |
| 2. Property Controlling in Section | S | _____ | T | _____ | _____ |
| | S | _____ | T | _____ | _____ |
| 3. Miscellaneous Property in Sec. | S | _____ | T | _____ | _____ |
| | S | _____ | T | _____ | _____ |

Register of Deeds Stamp & File Number

4. Lot No. _____, Recorded Plat _____
5. Private Claims _____

A	B	C	D	E	F	G	H	I	J	K	L	M
2	6	5	4	3	2	1						
3												
4	7	8	9	10	11	12						
5												
6	18	17	16	15	14	13						
7												
8	19	20	21	22	23	24						
9												
10	30	29	28	27	26	25						
11												
12	31	32	33	34	35	36						
13												

I, CARL F. ROSER, in a field survey on OCTOBER 28, 19 93, do hereby certify that under requirements of P.A. 74, Michigan P.A. of 1970, the corner points mentioned in lines 1 and 2 above were in conformance with regulations and rules therefore as required in the current manual of survey instructions of the United States Department of the Interior, Bureau of Land Management or by a decree of a Court of Law and/or that the corner points mentioned in lines 3, 4 and 5 above were in conformance with the rules of the Michigan Board of Land Surveyors or by a Decree of a Court of Law; established, re-established, monumented, re-monumented, recovered, found as expressed below:

NOTE: Not more than 4 corners, all in the same town and range, may be recorded on this certificate.

- A. Description of original monument and accessories and/or subsequent restoration:
- | | | |
|------|------|------|
| K-11 | K-13 | L-11 |
|------|------|------|

(NO EVIDENCE OF G.L.O. CORNER, B.T.'S, LINE TREES & TOPOGRAPHY, AS CALLED OUT IN THE G.L.O. LINE NOTES; UNLESS NOTED IN ITEM "B" BELOW.)


B. CONT: W/BOAT SPIKE. PLAN'S ALSO SAY CTR OF HWY IS 21.04' WEST.

- B. Description of corner evidence found and/or method applied in restoring or reestablishing corner:

K-11 FD PIPE IN MON BOX FOR NW COR S-36. CTR N-S B.TOP RD, M-30, IS 2' EAST. CTR BIT RD WEST IS 1' S & COR IS IN LINE WITH CTR BIT RD TO EAST. FITS 1950 MSHD M-30 PLAN DATA.	K-13 FD BOLT IN MON BOX FOR SW COR S-36. CTR OF M-30, IN CURVE, IS 21' WEST. COR IS IN LINE WITH CTR M-30 ON TO NORTH. COR FITS ONE MSHD WIT TO NE. B.TOP RD SOUTH IS 133' EAST. 1950 MSHD SURVEY NOTES INDICATE FD LARGE STONE & WOOD STAKE; PLAN & PROFILE SHEET #5, L-88-A-2(1950-51-54) NOTE STONE & STK AS ABOVE & THEN INDICATE MON BOX - CONT ABOVE-	L-11 RE-ESTABLISHED N 1/4 COR S-36 MIDWAY & ON LINE BETWEEN FD NW COR S-36 & REESTABLISHED NE COR S-36. COR FALLS IN CTR E-W B.TOP ROAD.
---	---	--

- C. Description of monument for corner and accessories established to perpetuate locating the position of the corner:

K-11 FD 3/4" PIPE IN MON BOX. 8" SCOTCH PINE N45°E 114.7' NW COR 4' X 5' CONC SLAB W/STEEL UTILITY BX S65°E 66.0' SW COR CONC HEAD WALL N35°W 46.4'	K-13 FD 1" SQ HEAD BOLT 18" DEEP AT SW EDGE IN MON BOX. POWER POLE N55°E 72.00' CTR S END 15" CMP S35°E 46.2' CTR 4" SQ CONC R/W POST WEST 81.9' 1" GALV PIPE W/RLS CAP. NW COR S-5 T20N-R2E N88°11'E 133.37	L-11 DROVE 5/8" X 34" REROD W/RLS CAP. 15" ASH N40°W 45.15' 3" ASH N30°E 46.43' 8" CEDAR S10°E 57.90' 11" CEDAR S25°W 44.26'
---	---	--

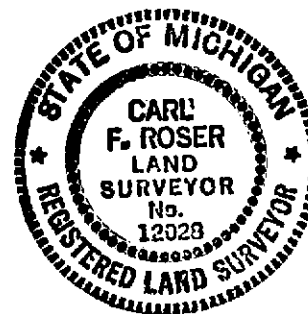

Signed by Carl F. Roser Date 6-20-95

Surveyor's Michigan License No. 12028