LAND CORNER RECORDATION CERTIFICATE

Filing Requirement of Act 74, Mich. P.A. 1970

For corners in
OGEMAW
(County)

	Located In:	Corner Code #
1. Public Land Survey	T 21N R 2E	B-13, C-12
	T ___ R ___	C-13
	T ___ R ___	
	T ___ R ___	
2. Property Controlling	S 31 T ___ R ___	16
in Section	S ___ T ___ R ___	
3. Miscellaneous	S ___ T ___ R ___	
Property in Sec.	S ___ T ___ R ___	

Register of Deeds Stamp & File Number

4. Lot No. _____ , Recorded Plat _____
5. Private Claims _____

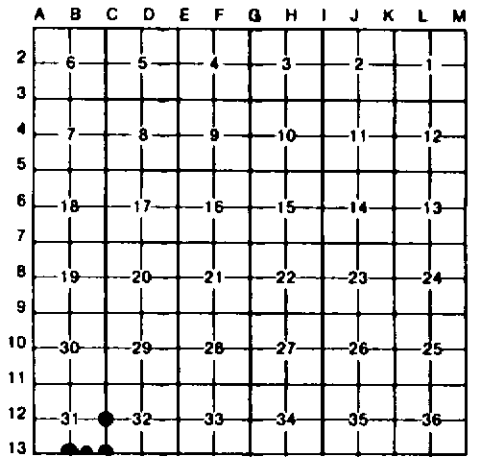

I, CARL F. ROSER , in a field survey on OCTOBER 27, , 19 93 , do hereby certify that under requirements of P.A. 74, Michigan P.A. of 1970, the corner points mentioned in lines 1 and 2 above were in conformance with regulations and rules therefore as required in the current manual of survey instructions of the United States Department of the Interior, Bureau of Land Management or by a decree of a Court of Law and/or that the corner points mentioned in lines 3, 4 and 5 above were in conformance with the rules of the Michigan Board of Land Surveyors or by a Decree of a Court of Law; established, re-established, monumented, re-monumented, recovered, found as expressed below:

NOTE: Not more than 4 corners, all in the same town and range, may be recorded on this certificate.

A. Description of original monument and accessories and/or subsequent restoration:

B-13 C-12 C-13 16

(NO EVIDENCE OF G.L.O. CORNER, B.T'S, LINE TREES & TOPOGRAPHY, AS CALLED OUT IN THE G.L.O. LINE NOTES; UNLESS NOTED IN ITEM "B" BELOW.)

STATE OF MICHIGAN
CARL F. ROSER
LAND SURVEYOR
No. 12028
REGISTERED LAND SURVEYOR

B. Description of corner evidence found and/or method applied in restoring or reestablishing corner:

B-13
REESTB. S1/4 COR OF SEC 31, ON LINE BETWEEN SW & SE OF SEC 31 AND AT PROP.-MEAS. TO #U.S. (RUN-OUT SEC) BET SAID COR'S. #USED U.S. G.L.O.(GEN. LAND OFFICE) SURVEY ORIG. OF 82.00 CHAINS - RESURVEY SHOWED 87 CH'S, BUT THEY BOOTED IT, SO USED 82 CH'S FOR P.M. OLD LEANING FN COR (B-W FN REMAINS N & W) IS N32°10'E, 120.0'. OLD E-W FN IS 93'± NORTH.

C-12
REESTABLISHED E 1/4 COR OF S-31 MIDWAY & ON LINE BETWEEN FOUND SEC CORNER 1/2 MILE NORTH & REESTABLISHED SEC CORNER 1/2 MILE SOUTH. COR FALLS IN LINE W/EAST EDGE OF TRAIL ROAD TO NORTH.

C-13
ESTABLISHED SW COR S-32 AT RECORD U.S. DIST WEST OF Restor. NE COR S-4, T20N-R2E & ON LINE BETWEEN FD NE S-4 & FD S 1/4 COR S-32, T21N-R2E. CTR OF TRAIL RD (CURVING W'LY & NE & SE) IS 152' NORTH. CTR OF TRAIL RD SOUTH IS 153' EAST.

16
ESTABLISHED SW COR OF E 1/2 OF SE 1/4 OF S-31 PER STANDARD BLM INSTRUCTIONS. DROVE 5/8" X 34" REROD WITH CEDAR POST N88°05'49"E, 329.51' FOR SW COR OF E 1/2 OF SW 1/4 OF SE 1/4 OF SE 1/4 OF SEC 31.

C. Description of monument for corner and accessories established to perpetuate locating the position of the corner:

B-13
SET DNR MON & CED POST.

10" MAPLE	N65°W	44.43'
18" MAPLE	N15°E	47.03'
23" SPRUCE	N60°E	48.53'
DNR MON N 1/4 S-4 T20N-R2E	N88°06'E	126.30'

C-12
SET DNR MON & CEDAR POST.

3" W BIRCH	N45°W	18.66'
3" MAPLE	N70°E	13.85'
3" MAPLE	S40°E	19.40'
3" ASH	S60°W	18.30'

C-13
DR 1" X 60" GALV PIPE W/ALUM CAP. SET CED POST.

4" ELM	N50°W	9.9'
6" ASH	N05°W	11.6'
6" ASH	N15°E	16.8'
NW S-3, DNR MON T20N-R2E	N88°25'E	143.20'

16
DR 5/8" X 34" REROD W/RLS CAP. SET CED POST W/LOC TAG.

2" TW SPRUCE	N55°W	34.22'
17" B OAK	N35°W	44.18'
5" B OAK	N60°E	19.25'
DR 5/8" REROD W/LS CAP FOR E 1/8 COR ON N LINE S-4, T20N-R2E	N88°05'49E	134.75

Signed by Carl F. Roser Date 6-20-95

Surveyor's Michigan License No. 12028

FORM APPROVED BY MICHIGAN STATE BOARD OF LAND SURVEYORS, JAN. 28, 1971
REVISED MAY 14, 1975
REVISED JAN., 1983