LAND CORNER RECORDATION CERTIFICATE

Filing Requirement of Act 74, Mich. P.A. 1970

For corners in OGEMAW (County)

	Located In:	Corner Code ##
1. Public Land Survey	T 21N R 2E	C-10, C-11
	T ___ R ___	D-11
	T ___ R ___	
	T ___ R ___	
2. Property Controlling	S 31 T ___ R ___	2
in Section	S ___ T ___ R ___	
3. Miscellaneous	S ___ T ___ R ___	
Property in Sec.	S ___ T ___ R ___	

Register of Deeds Stamp & File Number

4. Lot No. _____ , Recorded Plat _____
5. Private Claims _____

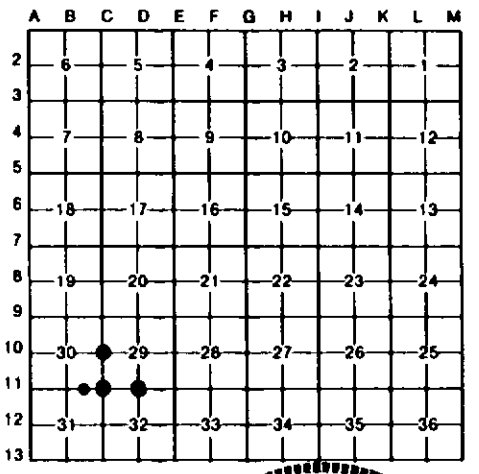

I, CARL F. ROSER, in a field survey on AUGUST 10, 19 93, do hereby certify that under requirements of P.A. 74, Michigan P.A. of 1970, the corner points mentioned in lines 1 and 2 above were in conformance with regulations and rules therefore as required in the current manual of survey instructions of the United States Department of the Interior, Bureau of Land Management or by a decree of a Court of Law and/or that the corner points mentioned in lines 3, 4 and 5 above were in conformance with the rules of the Michigan Board of Land Surveyors or by a Decree of a Court of Law; established, re-established, monumented, re-monumented, recovered, found as expressed below:

NOTE: Not more than 4 corners, all in the same town and range, may be recorded on this certificate.

A. Description of original monument and accessories and/or subsequent restoration:

C-10 C-11 D-11 2

(NO EVIDENCE OF G.L.O. CORNER, B.T'S, LINE TREES & TOPOGRAPHY, AS CALLED OUT IN THE G.L.O. LINE NOTES; UNLESS NOTED IN ITEM "B" BELOW.)

STATE OF MICHIGAN
CARL F. ROSER
LAND SURVEYOR
No. 12028
REGISTERED LAND SURVEYOR

B. Description of corner evidence found and/or method applied in restoring or reestablishing corner:

C-10
FD REROD WITH T.LAPHAM RLS CAP FOR W 1/4 COR S-29. COR FITS RLS G.HENNING, 1972 CERT OF SURVEY (LIBER 1, PG. 108) IN W 1/2-SW 1/4 S-29.

C-11
FD & ACCEPTED 1/2" REROD W/BATTERED RLS CAP IN ROAD INTERSEC, B.TOP E-W-N & TRAIL RD S, FOR NE COR OF S-31. COR FITS 1972 CERT OF SURVEY (L-1, PG 108) IN W 1/2 OF SW 1/4 BY G. HENNING, RLS #2240. FD 1/2" REROD ALSO FITS 1950 MEAS. DOWN RD TO W. BY RLS'S R.OSTLING & G.HENNING (NOW DECEASED) TO OLD FN N, 1/4 MI. W & OLD FN REMAINS S, 1/2 MI. W.

D-11
FD 3/4" PIPE WITH BATTERED PS CAP 2' SOUTH OF CTR E-W B.TOP RD FOR N 1/4 COR S-32. COR FITS R. HIGGINS & D. LEDY CERT'S OF SUR IN S-29. COR IS IN LINE W/OLD FN. REMAINS N'LY & RDW.FENCES TO WEST ARE 40' N. & 31' S. FD 3/4" PIPE ALSO FITS 1950 MEA. DOWN RD (FOR 1/2 MILE) FROM RD INTER VIC NW S-32, BY RLS'S R.OSTLING & G.HENNING (NOW DECEASED).

2
ESTABLISHED NW COR OF NE 1/4 - NE 1/4 S-31 PER STANDARD BLM INSTRUCTIONS. CTR OF E-W BLACKTOP RD IS 7.6' NORTH. COR IS IN LINE WITH CENTER OF DITCH SOUTH. OLD B.WIRE FENCE REMAINS TO SOUTH IS 4'± 3' EAST (B/WIRE FN REMAINS ARE ON EAST SIDE OF DITCH).

C. Description of monument for corner and accessories established to perpetuate locating the position of the corner:

C-10
FD 1/2" REROD W/RLS CAP #27595.

9" SCOTCH PINE	S85°E	37.15'
8" J PINE	S40°E	51.36'
POWER POLE	S65°W	82.97'
CTR N-S B.TOP RD.	WEST	1'

C-11
FD 1/2" REROD, RAISED UP WITH 1/2" X 8" REROD.

* UTILITY POLE	N45°W	52.13'
15" SPRUCE	N55°E	66.30'
12" W PINE	S10°E	50.23'
*20" W PINE	S40°W	54.95'

*WIT BY OTHERS.

D-11
FD 3/4" PIPE W/RLS CAP.

*13"SCOTCH PINE	N45°W	60.93'
*15" W PINE	S65°E	80.02'
9" R PINE	S10°W	49.00'
9" R PINE	N50°E	66.46'

*RLS D. LEDY WIT.

2
DROVE 5/8" X 34" REROD W/RLS CAP.

COR FN POST (FN E-W-N)	N08°W	43.63'
5" W PINE	S60°E	63.17'
4" W PINE	S45°E	49.30'
5" W PINE	S65°W	66.12'

Signed by Carl F. Roser Date 9-27-95

Surveyor's Michigan License No. 12028

FORM APPROVED BY MICHIGAN STATE BOARD OF LAND SURVEYORS, JAN. 28, 1971
REVISED MAY 14, 1975
REVISED JAN., 1983