LAND CORNER RECORDATION CERTIFICATE

Filing Requirement of Act 74, Mich. P.A. 1970

For corners in
OGEMAW
(County)

	Located In:	Corner Code ##
1. Public Land Survey	T 21N R 2E	D-9, E-9,
	T ___ R ___	E-10
	T ___ R ___	
	T ___ R ___	
2. Property Controlling	S 29 T ___ R ___	2
in Section	S ___ T ___ R ___	
3. Miscellaneous	S ___ T ___ R ___	
Property in Sec.	S ___ T ___ R ___	

Register of Deeds Stamp & File Number

4. Lot No. _____ , Recorded Plat _____
5. Private Claims _____

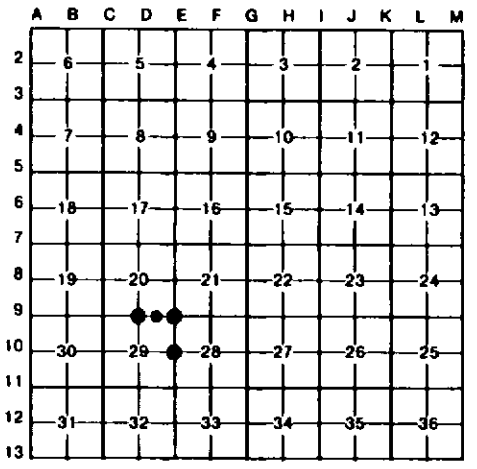

I, CARL F. ROSER, in a field survey on AUGUST 24, 19 93, do hereby certify that under requirements of P.A. 74, Michigan P.A. of 1970, the corner points mentioned in lines 1 and 2 above were in conformance with regulations and rules therefore as required in the current manual of survey instructions of the United States Department of the Interior, Bureau of Land Management or by a decree of a Court of Law and/or that the corner points mentioned in lines 3, 4 and 5 above were in conformance with the rules of the Michigan Board of Land Surveyors or by a Decree of a Court of Law; established, re-established, monumented, re-monumented, recovered, found as expressed below:

NOTE: Not more than 4 corners, all in the same town and range, may be recorded on this certificate.

A. Description of original monument and accessories and/or subsequent restoration:

D-9 E-9 E-10 2

(NO EVIDENCE OF G.L.O. CORNER, B.T'S, LINE TREES & TOPOGRAPHY, AS CALLED OUT IN THE G.L.O. LINE NOTES; UNLESS NOTED IN ITEM "B" BELOW.)
"B" CONT.- S-29 IS ONLY POSIT. THAT FITS GLO CALLS. SEE FOLDER 1of5 IN SUR FILE & MEMO W/ATTACH'S TO T.LAPHAM 5-27-93 & C.F.R.-T.L. MEETING 7-8-93.

STATE OF MICHIGAN
CARL F. ROSER
LAND SURVEYOR
No. 12028
REGISTERED LAND SURVEYOR

B. Description of corner evidence found and/or method applied in restoring or reestablishing corner:

D-9	E-9	E-10	2
REESTAB. N1/4 S-29 M.O.L. BETW FD SEC CORS 1/2 MILE E & W. THIS POSITION FITS R.HIGGINS '72 SUR OF S-29. FD BENT 1/2" REROD N70°20'E, 86.60' AS SET BY R.HIGGINS IN 1984 PER P.S. RICHARDSON'S SUR OF S-20. OLD E-W W/W FN, N OF GRV RD, IS N. 52'. EDGE OF SWP IS 153'± 10' E, GOVT CALL TO SWP EDGE= 198' EAST. NOTE: S.P. AND ON LINE BETW. NE & NW OF -CONT. ABOVE	FD 3/4" IRON ROD FOR NE COR OF S-29. COR FITS TWO 1965 MSHD (M.KOIVISTO) WIT REMAINS AND IS IN LINE WITH CTR OF GRAVEL RD WEST AND NORTH.	FD CONC POST FOR E 1/4 COR OF S-29 AS CALLED FOR IN R.HIGGINS 1982 SURVEY. COR IS IN LINE WITH FN SOUTH & FN WEST ± 5'. CTR OF TRAIL S'LY IS 33'± WEST AND FN S'LY IS 66'± WEST.	ESTABLISHED NW COR OF NE 1/4 OF NE 1/4 S-29 PER STANDARD BLM INSTRUCTIONS. COR FALLS IN CTR 14'± WIDE STREAM (S'LY ROAD DITCH) FLOWING EAST & THEN A THIN STREAM S'LY. FD P.S. R.HIGGINS 1/2" REROD, N70°44'E, 43.67'. SEE D-9 (N1/4 COR SEC. 29).

C. Description of monument for corner and accessories established to perpetuate locating the position of the corner:

D-9	E-9	E-10	2
DR 1"x 48" GALV PIPE W/RLS CAP. SET CEDAR POST.	FD 3/4" DIAMETER IRON ROD. FACE 8" X 6' TALL STEEL PIPE (N GATE POST) N80°E 28.8'	FD 4 1/2" SQ X 54" ABOVE GRD CONC POST.	DR 1" X 72" GALV PIPE W/RLS CAP.
8" ASH S85°W 6.4'	CTR S END 24" CMP S50°E 17.8'	#4" ELM S80°W 49.08'	5" ASH S45°E 13.0'
6" B. CHERRY N35°W 62.3'	5" ELM S35°W 34.96'	#6" ASH N55°W 47.13'	11" ELM S05°W 17.1'
8" ELM S05°E 8.2'	CTR N END 15" CMP N65°W 38.6'	#5" ASH N20°W 44.82'	6" ASH S45°W 19.5'
CTR 17' WIDE E-W GRAVEL RD. NORTH 26'	SET CED POST WITH LOC TAG. SOUTH 25'	# WIT'S TO APPROX. BOTTOM CTR. OF CONC. POST, LEANING A LITTLE TO WEST.	SET CED POST WITH LOC TAG SOUTH 10'
			CTR 14'± 2' WIDE E-W GRAVEL ROAD NORTH 17'

Signed by Carl F. Roser 9-27-95 Date _____

Surveyor's Michigan License No. 12028

FORM APPROVED BY MICHIGAN STATE BOARD OF LAND SURVEYORS, JAN. 28, 1971
REVISED MAY 14, 1975
REVISED JAN., 1983