LAND CORNER RECORDATION CERTIFICATE

Filing Requirement of Act 74, Mich. P.A. 1970

For corners in
OGEMAW
(County)

	Located In:	Corner Code ##
1. Public Land Survey	T 21N R 2E	G-11, G-12,
	T ___ R ___	G-13
	T ___ R ___	
	T ___ R ___	
2. Property Controlling	S 34 T ___ R ___	1
in Section	S ___ T ___ R ___	
3. Miscellaneous	S ___ T ___ R ___	
Property in Sec.	S ___ T ___ R ___	

Register of Deeds Stamp & File Number

4. Lot No. _____ , Recorded Plat _____
5. Private Claims _____

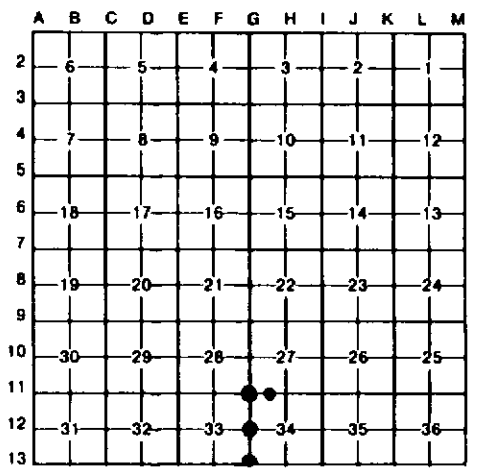

I, CARL F. ROSER , in a field survey on OCTOBER 25 , 19 93 , do hereby certify that under requirements of P.A. 74, Michigan P.A. of 1970, the corner points mentioned in lines 1 and 2 above were in conformance with regulations and rules therefore as required in the current manual of survey instructions of the United States Department of the Interior, Bureau of Land Management or by a decree of a Court of Law and/or that the corner points mentioned in lines 3, 4 and 5 above were in conformance with the rules of the Michigan Board of Land Surveyors or by a Decree of a Court of Law; established, re-established, monumented, re-monumented, recovered, found as expressed below:

NOTE: Not more than 4 corners, all in the same town and range, may be recorded on this certificate.

A. Description of original monument and accessories and/or subsequent restoration:

G-11 G-12 G-13 1

(NO EVIDENCE OF G.L.O. CORNER, B.T'S, LINE TREES & TOPOGRAPHY, AS CALLED OUT IN THE G.L.O. LINE NOTES; UNLESS NOTED IN ITEM "B" BELOW.)

B. Description of corner evidence found and/or method applied in restoring or reestablishing corner:

G-11
FD IRON W/P.S. T.LAPHAM CAP IN APPROX CTR E-W B.TOP RD FOR NW COR OF S-34. P.S. L.CAVANAGH FD CAM SHAFT FOR NE COR S-33 IN 1972 SUR FOR "PINE FOREST ACRES"; WE COULD NOT FIND THIS COR IN JULY 1992. P.S. T.LAPHAM RESET THIS COR IN NOV '92 PER OUR NO'S & L.CAVANAGH "PINE FOREST ACRES" SURVEY IN S-33.

G-12
FD REROD AS SET BY P.S. T.LAPHAM FOR E 1/4 COR S-33. FD REMAINS OLD E-W B.WIRE FN 23'± 3' SOUTH. ONE STRAND OF SMOOTH WIRE TO NORTH IS 50'± EAST. COR FITS NE COR OF LOT 10, "PINE FOREST ACRES", 662.08' NORTH.

G-13
FD REROD WITH L.CAVANAGH PS CAP FOR SEC COR COMMON TO SECTIONS 33 & 34. N-S LOGGING TRAIL IS 128'± EAST.

1
ESTABLISHED NE COR OF W 1/2 OF NW 1/4 S-34 PER STANDARD BLM INSTRUCTIONS. COR FALLS IN APPROX CTR E-W B.TOP RD. FD A 1/2" REROD SOUTH, 34.17'

STATE OF MICHIGAN
CARL F. ROSER
LAND SURVEYOR
No. 12028
REGISTERED LAND SURVEYOR

C. Description of monument for corner and accessories established to perpetuate locating the position of the corner

G-11
FD 1/2" REROD W/RLS CAP.
#POWER POLE N30°W 44.27'
#GATE POST N50°E 66.53'
8" W PINE S20°E 48.69'
SET CED POST W/LOC TAG BESIDE FD 1/2" REROD W/RLS CAP S. 33'
#FD 1/2" REROD W/RLS CAP #17614 S50°W 45.81'
#= LLS T.LAPHAM 1992 WITS.

G-12
SET DNR MON IN PLACE OF FD 1/2" REROD W/RLS CAP.
#15" TRPL OAK N70°W 17.13
10" R PINE N60°E 53.33'
#8" J PINE S40°E 19.68'
#6" TRPL MAPLE S05°W 48.02'
FD OLD 1 1/4" X 2" ABOVE GRD GALV PIPE S20°E 23.66'
#LLS T.LAPHAM 1992 WITS.

G-13
FD 1/2" X 18" REROD W/RLS CAP. REPLACED W/DNR MON & SET CED POST.
#14" W PINE N55°W 39.9'
3" W PINE N20°W 34.1'
#14" W PINE N50°E 27.1'
SEC. COR TO SEC'S 1 & 2, T20N R2E S88°10'W 48.72'
#RLS L. CAVANAGH WITS.

1
DROVE 5/8" X 34" REROD W/RLS CAP.
POWER POLE N05°E 31.01
4" W PINE S25°W 75.7'
8" CEDAR S50°W 77.5'
SET CED POST W/ LOC TAG SOUTH 33'

Signed by Carl F. Roser Date 9-27-95

Surveyor's Michigan License No. 12028

FORM APPROVED BY MICHIGAN STATE BOARD OF LAND SURVEYORS, JAN. 28, 1971
REVISED MAY 14, 1975
REVISED JAN., 1983