# LAND CORNER RECORDATION CERTIFICATE

**Filing Requirement of Act 74, Mich. P.A. 1970**

For corners in
OGEMAW
(County)

| | Located In: | Corner Code #/# |
|---|---|---|
| 1. Public Land Survey | T 21N R 2E | K-11, K-12, |
| | T ___ R ___ | K-13 |
| | T ___ R ___ | |
| | T ___ R ___ | |
| 2. Property Controlling | S ___ T ___ R ___ | |
| in Section | S ___ T ___ R ___ | |
| 3. Miscellaneous | S ___ T ___ R ___ | |
| Property in Sec. | S ___ T ___ R ___ | |

**Register of Deeds Stamp & File Number**

4. Lot No. _____ , Recorded Plat _____
5. Private Claims _____

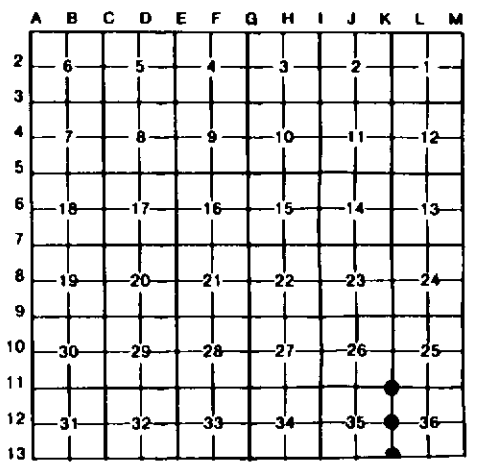


I, CARL F. ROSER, in a field survey on OCTOBER 28, 19 93, do hereby certify that under requirements of P.A. 74, Michigan P.A. of 1970, the corner points mentioned in lines 1 and 2 above were in conformance with regulations and rules therefore as required in the current manual of survey instructions of the United States Department of the Interior, Bureau of Land Management or by a decree of a Court of Law and/or that the corner points mentioned in lines 3, 4 and 5 above were in conformance with the rules of the Michigan Board of Land Surveyors or by a Decree of a Court of Law; established, re-established, monumented, re-monumented, recovered, found as expressed below:

**NOTE: Not more than 4 corners, all in the same town and range, may be recorded on this certificate.**

A. Description of original monument and accessories and/or subsequent restoration:

K-11 K-12 K-13

(NO EVIDENCE OF G.L.O. CORNER, B.T'S, LINE TREES & TOPOGRAPHY, AS CALLED OUT IN THE G.L.O. LINE NOTES; UNLESS NOTED IN ITEM "B" BELOW.)

B. Description of corner evidence found and/or method applied in restoring or reestablishing corner:

K-11

FD SPIKE FOR NE COR S-35. K.J.OSTLING IN 1972 DEPT. SUR. OF S-35 SAID "SET SPIKE OVER EXISTING R.R. RAIL". COR ALSO FITS M. KOIVISTO 1965, MSHD WITS. CTR OF E-W B.TOP RD IS 1 1/2' NORTH. CTR GRAVEL RD NORTH IS 7'± EAST AND COR IS IN LINE WITH CTR GRAVEL ROAD SOUTH.

K-12

FD REROD WITH P.S. D.LEDY CAP FOR E 1/4 COR S-35. COR FITS K.J. OSTLING 1972 DEPT SURVEY OF S-35. REROD IS DRIVEN THRU NORTH SIDE OF 18' CMP (THAT RUNS E-W UNDER RD) & 3.4' WEST OF EAST END OF CMP. CTR OF N-S GRAVEL RD IS 12'± WEST.

K-13

FD 1/2" REROD IN GRAVEL RD, IN CURVE, FOR SE COR S-35. COR FITS K.J.OSTLING'S DEPT SURVEY OF S-35 IN 1972. CTR OF GRAVEL RD TO NORTH IS 2'± EAST AND CTR OF GRAVEL RD TO W IS 3'± SOUTH.

C. Description of monument for corner and accessories established to perpetuate locating the position of the corner:

K-11

FD LARGE SPIKE

| | | |
|---|---|---|
| #22" TW WILLOW | N30°W | 64.97' |
| 8" W PINE | N50°E | 86.81' |
| #SPK IN POWER POLE | S45°E | 62.40' |
| #11" MAPLE | S50°W | 94.17' |

#WIT BY OTHERS.

K-12

FD 1/2" X 24" REROD W/RLS CAP.

| | | |
|---|---|---|
| #26" ASH | N30°W | 65.93' |
| #POWER POLE | N45°E | 35.22' |
| 6" R PINE | S55°W | 55.83' |
| #PK IN FACE OLD COR FN POST | WEST | 39.95' |

#WIT BY OTHERS.

K-13

FD 1/2" REROD.

| | | |
|---|---|---|
| #14" J PINE | N45°W | 69.08' |
| 6" W PINE | S10°E | 77.04' |
| 11" W PINE | S40°W | 76.75' |
| #POWER POLE | S70°W | 114.13' |
| 1/2" REROD NE S-6 T20N R2E | S88 27'W | 496.96' |

#RLS N. CALDWELL 1965 WIT.

STATE OF MICHIGAN
CARL F. ROSER
LAND SURVEYOR
No. 12028
REGISTERED LAND SURVEYOR

Signed by Carl F. Roser Date 9-27-95

Surveyor's Michigan License No. 12028

FORM APPROVED BY MICHIGAN STATE BOARD OF LAND SURVEYORS, JAN. 28, 1971
REVISED MAY 14, 1975
REVISED JAN., 1983