

**SURVEY &
REMONUMENTATION**

APR 29 1996

COMMISSION

**LAND CORNER RECORDATION CERTIFICATE
Filing Requirement of Act 74, Mich. P.A. 1970**

For corners in

Ogemaw (County)	Located In:	Corner Code #
1. Public Land Survey	T <u>24</u> NR <u>2E</u>	<u>A-13</u>
	T ___ R ___	_____
	T ___ R ___	_____
	T ___ R ___	_____
2. Property Controlling In Section	S ___ T ___ R ___	_____
	S ___ T ___ R ___	_____
3. Miscellaneous Property in Sec.	S ___ T ___ R ___	_____
	S ___ T ___ R ___	_____

LIBER 3 PAGE 37

STATE OF MICHIGAN
OGEMAW COUNTY
RECORDED

28 DEC 95 3:23 P.M.

WANDA MUZIK
REGISTER OF DEEDS

Register of Deeds Stamp & File Number

4. Lot No. _____, Recorded Plat _____
5. Private Claims _____

I, Timothy L. Lapham, in a field survey on December, 1995 do hereby state that under requirements of P.A. 74, Michigan P.A. of 1970, the corner points mentioned in lines 1 and 2 above were in conformance with regulations and rules therefore as required in the current manual of survey instructions of the United States Department of the Interior, Bureau of Land Management or by a decree of a Court of Law and/or that the corner points mentioned in lines 3, 4 and 5 above were in conformance with the rules of the Michigan Board of Land Surveyors or by a Decree of a Court of Law; established, re-established, monumented, recovered, found as expressed below:

	A	B	C	D	E	F	G	H	I	J	K	L	M
1													
2	6		5		4		3		2		1		
3													
4	7		8		9		10		11		12		
5													
6	18		17		16		15		14		13		
7													
8	19		20		21		22		23		24		
9													
10	30		29		28		27		26		25		
11													
12	31		32		33		34		35		36		
13													

NOTE: Not more than 2 corners, all in the same town and range, may be recorded on this certificate.

A. Description of original monument and accessories and/or subsequent restoration:

A-13: GLO Clason 1838, Set Post, 6" Spr. Pine N36E 22 lns, 6" Spr. Pine N44W 10 lns;
LCRC Cavanagh 9/6/72(Rec 1-11, 9/23/72), Found 1/2" Bar, 3 Wits;
LCRC Ostling 9/4/80(Rec 1-221, 11/18/80), Found 1/2" Bar, 3 Wits;
unrecorded 1956 & 1966 survey by Henning 1-1/4" pipe & 4 wits;
unrecorded 1967 road plans by Richardson, 4 wits;
unrecorded 1980 survey by K. Ostling 1/2" bar;


B. Description of corner evidence found and/or method applied in restoring or reestablishing corner:

A-13: No evidence of GLO survey found. Found 1/2" Capped iron in accord with record LCRC. Corner matches Henning And Ostling Surveys but could not verify that Richardson survey matches corner. Accepted found corner as best evidence of accepted corner. See dossier for additional information.

APPROVED BY
PEER REVIEW
12/11/95
DATE P.A. 345 of 1990

C. Description of monument for corner and accessories established to perpetuate locating the position of the corner:

A-13: Set 5/8"X36" rerod with 3-1/4" Aluminum Ogemaw Remon cap marked "27595 1995"
From Which:
NE 90.96' 10" Red pine w/spike
East 5' Centerline Road North
SE 43.50' 20" Oak w/spike
SW 43.86' 12" Jack Pine w/DNR spike
NW 49.19' 8" Jack Pine w/spike

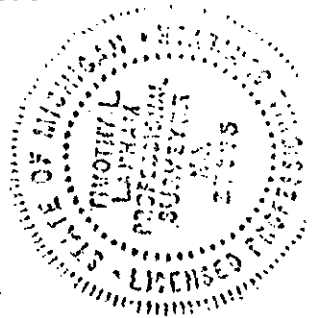

Signed by [Signature]
Surveyor's Michigan License No. 27595

Date 12/28/95