

**SURVEY &
REMONUMENTATION**

APR 29 1996

COMMISSION

LAND CORNER RECORDATION CERTIFICATE

Filing Requirement of Act 74, Mich. P.A. 1970

For corners in

Ogemaw

(County)

Located In:

Corner Code #

- | | | | | | |
|---------------------------------------|---|-----|---|----|------|
| 1. Public Land Survey | T | 24N | R | 2E | C-13 |
| | T | | R | | |
| | T | | R | | |
| | T | | R | | |
| 2. Property Controlling
in Section | S | | T | R | |
| | S | | T | R | |
| 3. Miscellaneous
Property in Sec. | S | | T | R | |
| | S | | T | R | |

LIBER 3 PAGE 39

STATE OF MICHIGAN
OGEMAW COUNTY
RECORDED

28 DEC 95 3:24 P.M.

WANDA HUZIK
REGISTER OF DEEDS
Stamp & File Number

4. Lot No. _____, Recorded Plat _____
5. Private Claims _____

	A	B	C	D	E	F	G	H	I	J	K	L	M
2	6	5	4	3	2								
3													
4	7	8	9	10	11	12							
5													
6	18	17	16	15	14	13							
7													
8	19	20	21	22	23	24							
9													
10	30	29	28	27	26	25							
11													
12	31	32	33	34	35	36							
13													

I, Timothy L. Lapham, in a field survey on December, 19 95, do hereby certify that under requirements of P.A. 74, Michigan P.A. of 1970, the corner points mentioned in lines 1 and 2 above were in conformance with regulations and rules therefore as required in the current manual of survey instructions of the United States Department of the Interior, Bureau of Land Management or by a decree of a Court of Law and/or that the corner points mentioned in lines 3, 4 and 5 above were in conformance with the rules of the Michigan Board of Land Surveyors or by a Decree of a Court of Law; established, re-established, monumented, re-monumented, recovered, found as expressed below:

NOTE: Not more than 4 corners, all in the same town and range, may be recorded on this certificate.

A. Description of original monument and accessories and/or subsequent restoration:

C-13: GLO Clason 1838, Set Post, 5" Spr. Pine N14E 11 lnks, 5" Spr. Pine N31W 7 lnks;
Survey Miller 3/21/74 (Rec 1-372-6, 4/10/74), No Cor Mat, No Wits;
Survey Ledy 5/15/85 (Rec 3-543-4, 7/12/85), Found 1/2" Bar, 1 Wit;
LCRC Lapham 1/20/89 (Rec 2-36, 3/22/89), Found Iron;
Henning 1956 & 1966 unrecorded survey 3 Wits;
Richardson 1967 Road Commission Plans, 2" pipe, 3 Wits.


B. Description of corner evidence found and/or method applied in restoring or reestablishing corner:

C-13: No evidence of GLO survey found. Found 1/2" iron in accord with LCRC 2-36. NOTE: Corner not in accord with Co. Rd. Plans. Accepted found corner as best evidence of accepted corner. See dossier for additional information.

APPROVED BY
PEER REVIEW
12/11/95 *JW*
DATE P.A. 345 of 1990

C. Description of monument for corner and accessories established to perpetuate locating the position of the corner:

C-13: Set 5/8" X 36" rerod with 3-1/4" Aluminum Ogemaw Remon cap marked "27595 1995"
From Which:
N39E 53.96' Spike in Guy Pole
S19W 83.32' Spike in Guy Pole
West 14.50' 5/8" Remon Monument
N59W 112.28' SE Cor House
N34W 39.60' DNR tag in Power Pole

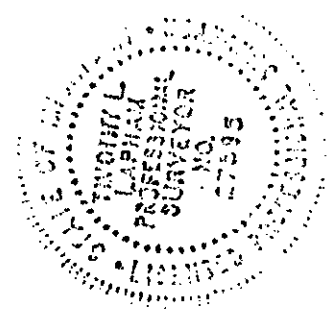

Signed by *Timothy L. Lapham*

Date 12/28/95

Surveyor's Michigan License No. 27595