

**SURVEY &
REMONUMENTATION**

APR 29 1996

**COMMISSION
LAND CORNER RECORDATION CERTIFICATE**
Filing Requirement of Act 74, Mich. P.A. 1970

LIBER 3 PAGE 40

STATE OF MICHIGAN
OGEMAW COUNTY
RECORDED

28 DEC 95 3:24 P.M.

WANDA NUZIK
REGISTER OF DEEDS

Register of Deeds Stamp & File Number

For corners in
Ogemaw

(County)

Located In:

Corner Code #

- | | | | | | |
|---------------------------------------|---|-----|---|----|------|
| 1. Public Land Survey | T | 24N | R | 2E | D-13 |
| | T | | R | | |
| | T | | R | | |
| | T | | R | | |
| 2. Property Controlling
In Section | S | T | R | | |
| | S | T | R | | |
| 3. Miscellaneous
Property in Sec. | S | T | R | | |
| | S | T | R | | |

4. Lot No. _____, Recorded Plat _____
5. Private Claims _____

	A	B	C	D	E	F	G	H	I	J	K	L	M
2	6	5	4	3	2	1							
3													
4	7	8	9	10	11	12							
5													
6	18	17	16	15	14	13							
7													
8	19	20	21	22	23	24							
9													
10	30	29	28	27	26	25							
11													
12	31	32	33	34	35	36							
13													

I, Timothy L. Lapham, in a field survey on December, 19 95, do hereby certify that under requirements of P.A. 74, Michigan P.A. of 1970, the corner points mentioned in lines 1 and 2 above were in conformance with regulations and rules therefore as required in the current manual of survey instructions of the United States Department of the Interior, Bureau of Land Management or by a decree of a Court of Law and/or that the corner points mentioned in lines 3, 4 and 5 above were in conformance with the rules of the Michigan Board of Land Surveyors or by a Decree of a Court of Law; established, re-established, monumented, re-monumented, recovered, found as expressed below:

NOTE: Not more than 4 corners, all in the same town and range, may be recorded on this certificate.

A. Description of original monument and accessories and/or subsequent restoration:

D-13: GLO Clason 1838, Set Post, 8" Spr. Pine N64E 33lnks, 8" Spr. Pine N47W 36lnks;
LCRC Lapham 2/2/89 (Rec 2-40, 3/22/89), Found 1/2" Iron, 6 Wits;
Road Plans, Richardson 1967, 1-1/4" Pipe, 4 Wits;


B. Description of corner evidence found and/or method applied in restoring or reestablishing corner:

D-13: No evidence of GLO found. Found 1/2" iron in accord with record LCRC 2-40. Corner matches stationing on Road Plans between D-13 and E-13. Accepted found corner as best evidence of properly positioned corner. See dossier for additional information.

APPROVED BY PEER REVIEW	
12/11/95	TL
DATE	P.A. 345 of 1990

C. Description of monument for corner and accessories established to perpetuate locating the position of the corner:

D-13: Set 5/8" X36" rerod with 3-1/4" Aluminum Ogemaw Remon Cap marked "27595 1995"
From Which:
North 1.0' Centerline Pavement
East 40' Centerline Trail North-South
S30E 42.50' 12" Red Pine
S32W 58.42' 12" Jack Pine w/spike
West 23.44 5/8" Remon Monument
N11W 62.99' 12" Jack Pine

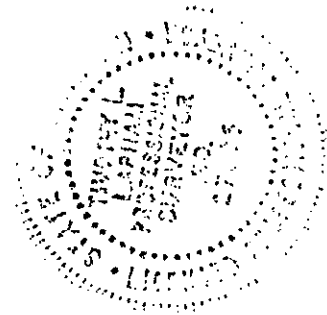

Signed by [Signature]

Date 12/28/95

Surveyor's Michigan License No. 27595