

**SURVEY &
REMONUMENTATION**

APR 29 1996

COMMISSION LAND CORNER RECORDATION CERTIFICATE

Filing Requirement of Act 74, Mich. P.A. 1970

For corners in

Ogemaw (County)	Located In:	Corner Code #
1. Public Land Survey	T 24NR 2E	E-13
	T R	
	T R	
	T R	
2. Property Controlling in Section	S T R	
	S T R	
3. Miscellaneous Property in Sec.	S T R	
	S T R	

LIBER 3 PAGE 41

STATE OF MICHIGAN
OGEMAW COUNTY
RECORDED

28 DEC 95 3:24 P.M.

WANDA HUZIK
REGISTER OF DEEDS

Register of Deeds Stamp & File Number

4. Lot No. _____, Recorded Plat _____
5. Private Claims _____

	A	B	C	D	E	F	G	H	I	J	K	L	M
2	8		5		4		3		2		1		
3													
4	7		6		9		10		11		12		
5													
6	18		17		16		15		14		13		
7													
8	19		20		21		22		23		24		
9													
10	30		29		28		27		26		25		
11													
12	31		32		33		34		35		36		
13													

I, Timothy L. Lapham, in a field survey on December, 1995, do hereby certify that under requirements of P.A. 74, Michigan P.A. of 1970, the corner points mentioned in lines 1 and 2 above were in conformance with regulations and rules therefore as required in the current manual of survey instructions of the United States Department of the Interior, Bureau of Land Management or by a decree of a Court of Law and/or that the corner points mentioned in lines 3, 4 and 5 above were in conformance with the rules of the Michigan Board of Land Surveyors or by a Decree of a Court of Law; established, re-established, monumented, re-monumented, recovered, found as expressed below:

NOTE: Not more than 4 corners, all in the same town and range, may be recorded on this certificate.

A. Description of original monument and accessories and/or subsequent restoration:

E-13: GLO Clason 1838, Set Post, 10" Spr. Pine N21E 57lnks,, 8" Spr. Pine N58W 35lnks;
Survey Cavanagh 9/26/73(Rec 1-285-91, 9/20/73) Set 1/2" Steel Bar, 3 Wits;
LCRC Cavanagh 9/26/93(Rec 1-48, 11/16/93), set bar and 3 witnesses;
LCRC Lapham 2/2/89(Rec 2-40, 3/22/89), Found 1/2" Iron, 4 Wits;
Road Plans, Richardson, 1967, 1-1/4" Pipe, 3 Wits;


B. Description of corner evidence found and/or method applied in restoring or reestablishing corner:

E-13: No evidence of GLO survey found. Found 1/2" rerod in accord with previous record LCRC's. Stationing on Road Plans matches East and West. Accepted found corner as best evidence of the accepted corner position. See dossier for additional information.

APPROVED BY
PEER REVIEW
12/11/95
DATE P.A. 345 of 1990

C. Description of monument for corner and accessories established to perpetuate locating the position of the corner:

E-13: Set 5/8"X36" rerod with 3-1/4" Aluminum Ogemaw Remon cap marked "27595 1995"
From Which:
North 0.3' Centerline Pavement
S30E 49.49' 8" Jack Pine
S37W 75.77' 10" Oak
West 12.52' 5/8" Remon Monument
N05W 52.69' Power Pole

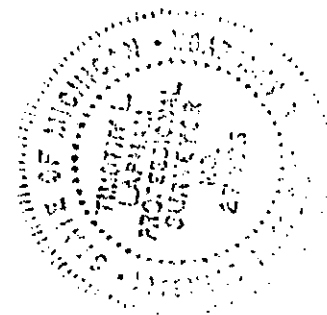

Signed by *[Signature]*
Surveyor's Michigan License No. 27595

Date 12/28/95