

SURVEY & REMONUMENTATION

APR 29 1995

COMMISSION

LAND CORNER RECORDATION CERTIFICATE
Filing Requirement of Act 74, Mich. P.A. 1970

For corners in

Ogemaw (County)	Located In:	Corner Code #
1. Public Land Survey	T 24NR 2E	F-13
	T R	
	T R	
	T R	
2. Property Controlling in Section	S T R	
	S T R	
3. Miscellaneous Property in Sec.	S T R	
	S T R	

LIBER 3 PAGE 42

STATE OF MICHIGAN
OGEMAW COUNTY
RECORDED

28 DEC 95 3:24 P.M.

WANDA MUZIK
REGISTER OF DEEDS

Register of Deeds Stamp & File Number

4. Lot No. _____, Recorded Plat _____
5. Private Claims _____

I, Timothy L. Lapham, in a field survey on December, 19 95 do hereby state that under requirements of P.A. 74, Michigan P.A. of 1970, the corner points mentioned in lines 1 and 2 above were in conformance with regulations and rules therefore as required in the current manual of survey instructions of the United States Department of the Interior, Bureau of Land Management or by a decree of a Court of Law and/or that the corner points mentioned in lines 3, 4 and 5 above were in conformance with the rules of the Michigan Board of Land Surveyors or by a Decree of a Court of Law; established, re-established, monumented, recovered, found as expressed below:

NOTE: Not more than 2 corners, all in the same town and range, may be recorded on this certificate.

	A	B	C	D	E	F	G	H	I	J	K	L	M
1													
2	6	5	4	3	2								
3													
4	7	8	9	10	11	12							
5													
6	18	17	16	15	14	13							
7													
8	19	20	21	22	23	24							
9													
10	30	29	28	27	26	25							
11													
12	31	32	33	34	35	36							
13													

A. Description of original monument and accessories and/or subsequent restoration:

F-13: GLO Clason 1838, Set Post, 14" Y. Pine N20E 48lnks, 12" Y. Pine N48W 41lnks;
LCRC Cavanagh 9/26/73(Rec 1-48) found pipe, 3 witnesses;
Survey Cavanagh 9/14/73(Rec 1-285-91, 9/20/73), Found Pipe & Cap, 3 Wits;
LCRC Lapham 2/2/89(Rec 2-38, 3/22/89), Found 1/2" Capped Iron, 3 Wits;
1967 Road Survey by Richardson, 1-1/4" Pipe and 4 Wits with GLO evidence;


B. Description of corner evidence found and/or method applied in restoring or reestablishing corner:

F-13: No evidence of GLO found. Found 5/8" capped iron. Distance to West matches Survey 1-285-91. 1 witness remains from LCRC 1-48. Corner matches LCRC 2-38. Accepted found iron as true perpetuation of the original corner position. See dossier for additional information.

APPROVED BY
PEER REVIEW
12/11/95
DATE P.A. 345 of 1990

C. Description of monument for corner and accessories established to perpetuate locating the position of the corner:

F-13: SET 5/8"x36" REROD WITH ALUMINUM REMON CAP
EAST 7.64 CLOSING CORNER MONUMENT
N02W 18.33 10" OAK WITH SPIKE
S64E 40.43 12" OAK WITH SPIKE
S61W 49.26 6" RED OAK WITH SPIKE
NORTH 2' CENTERLINE FIRELANE
S03E 62.56 6" JACK PINE WITH SPIKE

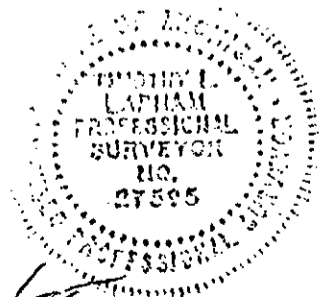

Signed by [Signature]
Surveyor's Michigan License No. 27595

Date 12/28/95