

SURVEY & REMONUMENTATION

APR 29 1996

COMMISSION

LAND CORNER RECORDATION CERTIFICATE

Filing Requirement of Act 74, Mich. P.A. 1970

For corners in
Ogemaw

(County)	Located In:	Corner Code #/
1. Public Land Survey	T 24N R 2E	H-13
	T ___ R ___	_____
	T ___ R ___	_____
	T ___ R ___	_____
2. Property Controlling in Section	S ___ T ___ R ___	_____
	S ___ T ___ R ___	_____
3. Miscellaneous Property in Sec.	S ___ T ___ R ___	_____
	S ___ T ___ R ___	_____

LIBER 3 PAGE 44

STATE OF MICHIGAN
OGEMAW COUNTY
RECORDED

28 DEC 95 3:25 P.M.

WANDA HUZIK
REGISTER OF DEEDS
Register of Deeds Stamp & File Number

4. Lot No. _____, Recorded Plat _____
5. Private Claims _____

	A	B	C	D	E	F	G	H	I	J	K	L	M
2	6	5	4	3	2	1							
3													
4	7	8	9	10	11	12							
5													
6	16	17	18	15	14	13							
7													
8	19	20	21	22	23	24							
9													
10	30	29	28	27	26	25							
11													
12	31	32	33	34	35	36							
13													

Timothy L. Lapham, in a field survey on December 19 95, do hereby certify that under requirements of P.A. 74, Michigan P.A. of 1970, the corner points mentioned in lines 1 and 2 above were in conformance with regulations and rules therefore as required in the current manual of survey instructions of the United States Department of the Interior, Bureau of Land Management or by a decree of a Court of Law and/or that the corner points mentioned in lines 3, 4 and 5 above were in conformance with the rules of the Michigan Board of Land Surveyors or by a Decree of a Court of Law; established, re-established, monumented, re-monumented, recovered, found as expressed below:

NOTE: Not more than 4 corners, all in the same town and range, may be recorded on this certificate.

A. Description of original monument and accessories and/or subsequent restoration:

H-13: GLO Clason 1838, Set Post, 11" Spr. Pine N53E 40 lnks, 8" Spr. Pine S63W 56 lnks; LCRC DeLameter 11/13/87 (Rec 1-358, 11/16/87), Found 1-1/2" Iron Pipe, 3 Wits; LCRC Lapham 2/2/89 (Rec 2-38, 3/22/89), Found 1-1/2" Pipe, Found DeLameter Wits, 3 Additional Wits;


B. Description of corner evidence found and/or method applied in restoring or reestablishing corner:

H-13: No evidence of GLO survey found. Found 1-1/2" pipe in accord with both LCRC's of record. No other evidence of corner position found. Accepted found pipe as best evidence of accepted corner position. See dossier for more information.

APPROVED BY
PEER REVIEW
12/11/95
DATE P.A. 345 of 1990

C. Description of monument for corner and accessories established to perpetuate locating the position of the corner:

H-13: Set 5/8"X36" rerod with 3-1/4" Aluminum Ogemaw Remon cap marked "27595 1995"
From Which:
N32E 73.77' 12" Oak w/spike
S34E 108.98' PK Nail in Power Pole
S11E 99.10' 20" Oak w/spike
South 30' Centerline of pavement
West 13.09' 5/8" Remon Monument
West 45' Centerline gravel road North
N10W 76.21' PK Nail in Power Pole

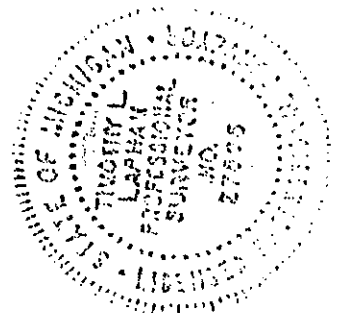

Signed by [Signature]
Surveyor's Michigan License No. 27595

Date 12/28/95