

**SURVEY & REMONUMENTATION**

APR 29 1996

COMMISSION

**LAND CORNER RECORDATION CERTIFICATE**  
Filing Requirement of Act 74, Mich. P.A. 1970

CIBER 1) 3 PAGE 45

For corners in

Ogemaw (County)	Located In:	Corner Code #
1. Public Land Survey	T 24N R 2E	I-13
	T _____ R _____	_____
	T _____ R _____	_____
	T _____ R _____	_____
2. Property Controlling In Section	S _____ T _____ R _____	_____
	S _____ T _____ R _____	_____
3. Miscellaneous Property in Sec.	S _____ T _____ R _____	_____
	S _____ T _____ R _____	_____

STATE OF MICHIGAN  
OGEHAW COUNTY  
RECORDED

28 DEC 95 3:25 P.M.

WANDA MUZIK  
REGISTER OF DEEDS

Register of Deeds Stamp & File Number

4. Lot No. \_\_\_\_\_, Recorded Plat \_\_\_\_\_  
5. Private Claims \_\_\_\_\_

	A	B	C	D	E	F	G	H	I	J	K	L	M
2	6	5	4	3	2	1							
3													
4	7	8	9	10	11	12							
5													
6	16	17	18	15	14	13							
7													
8	19	20	21	22	23	24							
9													
10	30	29	28	27	26	25							
11													
12	31	32	33	34	35	36							
13													

I, Timothy L. Lapham, in a field survey on December, 19 95, do hereby certify that under requirements of P.A. 74, Michigan P.A. of 1970, the corner points mentioned in lines 1 and 2 above were in conformance with regulations and rules therefore as required in the current manual of survey instructions of the United States Department of the Interior, Bureau of Land Management or by a decree of a Court of Law and/or that the corner points mentioned in lines 3, 4 and 5 above were in conformance with the rules of the Michigan Board of Land Surveyors or by a Decree of a Court of Law; established, re-established, monumented, re-monumented, recovered, found as expressed below:

**NOTE: Not more than 4 corners, all in the same town and range, may be recorded on this certificate.**

**A. Description of original monument and accessories and/or subsequent restoration:**

I-13: GLO Clason 1838, Set Post, 22" W. Pine N43E 70lnks, 9" W. Oak N42W 64lnks; Survey Caldwell 1/13/72 (Rec 1-95-7, 4/27/72), Found Consumers T Iron, 4 Wits; LCRC Caldwell 12/22/72 (Rec 1-29), Same as Survey 1-95-7; LCRC DeLamater 11/13/87 (Rec 1-358, 11/16/87), Found 1-1/2" Iron Pipe, 3 Wits; Consumers Power Survey 1967-8, Dorsey, established corner GLO dist. East of found closing corner I-1 T23N R2E


**B. Description of corner evidence found and/or method applied in restoring or reestablishing corner:**

I-13: No evidence of GLO survey Found. No accessories from any other record documents existing due to road construction. Corner matches distance to East from Survey 1-95-7 and Distance West to closing corner from GLO and Survey 1-95-7 and C.P.Co. Survey. Distance to K-13 4.65' shorter than C.P.Co. Survey. Accepted found corner as best available evidence of accepted corner position. See dossier for additional information.

APPROVED BY  
PEER REVIEW  
12/20/95  
DATE P.A. 345 of 1990

**C. Description of monument for corner and accessories established to perpetuate locating the position of the corner:**

I-13: Set 5/8" X 36" rerod with 3-1/4" Aluminum Ogemaw Remon cap marked "27595 1995"  
From Which:  
North 70.04' Iron  
N10E 85.58' 10" Twin Oak  
N42E 119.28' 8" Twin Oak  
South 0.85' Centerline Pavement  
S16W 51.92' Concrete Monument  
West 14.52 5/8" Remon Monument

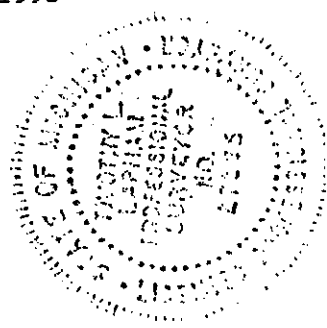

Signed by [Signature] Date 12/28/95  
Surveyor's Michigan License No. 27595