

**SURVEY & REMONUMENTATION**

APR 29 1996

**COMMISSION LAND CORNER RECORDATION CERTIFICATE**  
 Filing Requirement of Act 74, Mich. P.A. 1970

LIBER 3 PAGE 47

STATE OF MICHIGAN  
 Ogemaw County  
 RECORDED

28 DEC 95 3:25 P.M.

WANDA HUZIK  
 REGISTER OF DEEDS

Register of Deeds Stamp & File Number

| For corners in<br>Ogemaw              | (County) | Located In: | Corner Code # |
|---------------------------------------|----------|-------------|---------------|
| 1. Public Land Survey                 | T        | 24NR 2E     | K-13          |
|                                       | T        | R           |               |
|                                       | T        | R           |               |
|                                       | T        | R           |               |
| 2. Property Controlling<br>in Section | S        | T R         |               |
|                                       | S        | T R         |               |
| 3. Miscellaneous<br>Property in Sec.  | S        | T R         |               |
|                                       | S        | T R         |               |

4. Lot No. \_\_\_\_\_, Recorded Plat \_\_\_\_\_  
 5. Private Claims \_\_\_\_\_

I, Timothy L. Lapham, in a field survey on December, 19 95, do hereby certify that under requirements of P.A. 74, Michigan P.A. of 1970, the corner points mentioned in lines 1 and 2 above were in conformance with regulations and rules therefore as required in the current manual of survey instructions of the United States Department of the Interior, Bureau of Land Management or by a decree of a Court of Law and/or that the corner points mentioned in lines 3, 4 and 5 above were in conformance with the rules of the Michigan Board of Land Surveyors or by a Decree of a Court of Law; established, re-established, monumented, re-monumented, recovered, found as expressed below:

**NOTE: Not more than 4 corners, all in the same town and range, may be recorded on this certificate.**

|    | A  | B  | C  | D  | E  | F  | G | H | I | J | K | L | M |
|----|----|----|----|----|----|----|---|---|---|---|---|---|---|
| 2  | 6  | 5  | 4  | 3  | 2  | 1  |   |   |   |   |   |   |   |
| 3  |    |    |    |    |    |    |   |   |   |   |   |   |   |
| 5  |    |    |    |    |    |    |   |   |   |   |   |   |   |
| 6  | 16 | 17 | 16 | 15 | 14 | 13 |   |   |   |   |   |   |   |
| 7  |    |    |    |    |    |    |   |   |   |   |   |   |   |
| 8  | 19 | 20 | 21 | 22 | 23 | 24 |   |   |   |   |   |   |   |
| 9  |    |    |    |    |    |    |   |   |   |   |   |   |   |
| 10 | 30 | 29 | 28 | 27 | 26 | 25 |   |   |   |   |   |   |   |
| 11 |    |    |    |    |    |    |   |   |   |   |   |   |   |
| 12 | 31 | 32 | 33 | 34 | 35 | 36 |   |   |   |   |   |   |   |
| 13 |    |    |    |    |    |    |   |   |   |   |   |   |   |

**A. Description of original monument and accessories and/or subsequent restoration:**

K-13: GLO Clason 1838 Set Post, 14" Hard Maple N11E 17 lns, 9" Beech N30W 38 Lns;  
 Survey Caldwell 1/13/72 (Rec 1-94, 4/27/72), No Cor Mat, No Wits;  
 Survey Caldwell 1/13/72 (Rec 1-95-7, 4/27/72), Fd Iron, 4 Wits;  
 LCRC Caldwell 12/22/72 (Rec 1-30), Same as Caldwell 1-95-7;  
 Survey Caldwell 11/15/76 (Rec 2-288, 6/17/77) No Cor Mat, No Wits;  
 Survey Caldwell 11/20/80 (Rec 3-271, 1/26/81), No Cor Mat, No Wits;  
 LCRC Lapham 2/2/89 (Rec 2-68, 3/22/89), Fd Capped Iron, 3 Wits;  
 Survey, Consumers Power Co., Set T-iron, 3 Wits


**B. Description of corner evidence found and/or method applied in restoring or reestablishing corner:**

K-13: Found capped iron in accord with all evidence of record since GLO survey. No evidence of GLO corner found. Accepted found corner as best evidence of proper position of accepted corner. See dossier for additional information.

APPROVED BY  
 PEER REVIEW  
 12/28/95  
 DATE P.A. 345 of 1990

**C. Description of monument for corner and accessories established to perpetuate locating the position of the corner:**

K-13: Set 5/8" X 36" rerod with 3-1/4" Aluminum Ogemaw Remon cap marked "27595 1995"  
 From Which:  
 N48E 85.67' 10" Apple w/spike  
 S13E 47.47' Spike in Light Pole  
 S33W 153.56' 4" Elm w/spike  
 West 18.42' 5/8" Remon Monument

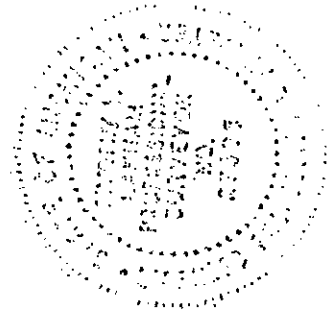

Signed by [Signature]  
 Surveyor's Michigan License No. 27595

Date 12/28/95