

SURVEY & REMONUMENTATION

APR 29 1996

COMMISSION

LAND CORNER RECORDATION CERTIFICATE
Filing Requirement of Act 74, Mich. P.A. 1970

LIBER 3 PAGE 48

STATE OF MICHIGAN
OGEMAW COUNTY
RECORDED

28 DEC 95 3:25 P.M.

WANDA HUZIK
REGISTER OF DEEDS

Register of Deeds Stamp & File Number

For corners in
Ogemaw

(County)

Located In:

Corner Code #

1. Public Land Survey	T	24NR	2E	L-13
	T	_____	R	_____
	T	_____	R	_____
	T	_____	R	_____
2. Property Controlling In Section	S	_____	T	R
	S	_____	T	R
3. Miscellaneous Property in Sec.	S	_____	T	R
	S	_____	T	R

4. Lot No. _____, Recorded Plat _____
5. Private Claims _____

I, Timothy L. Lapham, in a field survey on December, 19 95, do hereby certify that under requirements of P.A. 74, Michigan P.A. of 1970, the corner points mentioned in lines 1 and 2 above were in conformance with regulations and rules therefore as required in the current manual of survey instructions of the United States Department of the Interior, Bureau of Land Management or by a decree of a Court of Law and/or that the corner points mentioned in lines 3, 4 and 5 above were in conformance with the rules of the Michigan Board of Land Surveyors or by a Decree of a Court of Law; established, re-established, monumented, re-monumented, recovered, found as expressed below:

NOTE: Not more than 4 corners, all in the same town and range, may be recorded on this certificate.

	A	B	C	D	E	F	G	H	I	J	K	L	M
2	6	5	4	3	2	1							
3													
4	7	8	9	10	11	12							
5													
6	18	17	16	15	14	13							
7													
8	19	20	21	22	23	24							
9													
10	30	29	28	27	26	25							
11													
12	31	32	33	34	35	36							
13													

A. Description of original monument and accessories and/or subsequent restoration:

L-13: Clason 1838 Set post; 10" Beech N41E 35 Lnks, 10" Beech N14W 20 Lnks
Survey Caldwell 4/2/75 (Rec 2-11, 10/3/75) No Cor Mat, No Wits;
Survey Caldwell 11/15/76 (Rec 2-288, 6/17/77) No Cor Mat, No Wits;
LCRC Lapham 2/2/89 (Rec 2-68, 3/22/89) Fd Capped Iron, 3 Wits;
Survey Granger 9/23/93 (Rec 5-387-8, 12/2/93), 5 Wits;
Survey, Consumers Power Co. Found 3/8" Iron, No Wits;


B. Description of corner evidence found and/or method applied in restoring or reestablishing corner:

L-13: No evidence of GLO survey found. Found 1/2" iron, cap obliterated, in accord with Surveys of record. Accepted found corner as best available evidence of the position of the original corner. See dossier for additional information.

APPROVED BY
PEER REVIEW
12/11/95 *TL*
DATE P.A. 345 of 1990

C. Description of monument for corner and accessories established to perpetuate locating the position of the corner:

L-13: Set 5/8" X 36" rerod with 3-1/4" Aluminum Ogemaw Remon cap marked "27595 1995"
From Which:
North 0.8' Centerline Pavement
N50E 54.50' 8" Red Pine
S01W 35.70' Apple w/#16041 Tag
S10W 55.40' 12" Elm w/spike
S61W 71.91' 4X4 post w/spike
West 9.45' 5/8" Remon Monument

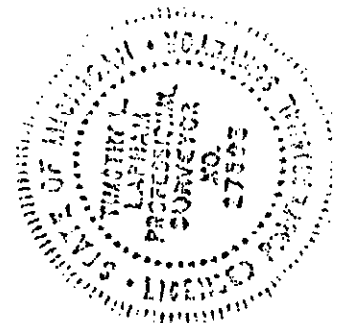

Signed by [Signature]
Surveyor's Michigan License No. 27595

Date 12/28/95