

**SURVEY &  
REMONUMENTATION**

JUL 23 1997

**COMMISSION**

**LAND CORNER RECORDATION CERTIFICATE  
Filing Requirement of Act 74, Mich. P.A. 1970**

For corners in  
OGEMAW

(County)

Located In:

Corner Code #

- |                                       |   |            |   |           |                           |
|---------------------------------------|---|------------|---|-----------|---------------------------|
| 1. Public Land Survey                 | T | <u>24N</u> | R | <u>3E</u> | <u>A-13</u>               |
|                                       | T | <u>24N</u> | R | <u>3E</u> | <u>M-13</u> <i>Seg #1</i> |
|                                       | T |            | R |           |                           |
|                                       | T |            | R |           |                           |
| 2. Property Controlling<br>in Section | S |            | T | R         |                           |
|                                       | S |            | T | R         |                           |
| 3. Miscellaneous<br>Property in Sec.  | S |            | T | R         |                           |
|                                       | S |            | T | R         |                           |
| 4. Lot No. _____, Recorded Plat _____ |   |            |   |           |                           |
| 5. Private Claims _____               |   |            |   |           |                           |

LIBER

**2** PAGE **269**  
STATE OF MICHIGAN  
OGEMAW COUNTY  
RECORDED

3 JAN 95 9:38 A.M.

WANDA MUZIK  
REGISTER OF DEEDS  
Register of Deeds Stamp & File Number

I, Timothy L. Lapham in a field survey on December, 1994, do hereby certify that under requirements of P.A. 74, Michigan P.A. of 1970, the corner points mentioned in lines 1 and 2 above were in conformance with regulations and rules therefore as required in the current manual of survey instructions of the United States Department of the Interior, Bureau of Land Management or by a decree of a Court of Law and/or that the corner points mentioned in lines 3, 4 and 5 above were in conformance with the rules of the Michigan Board of Land Surveyors or by a Decree of a Court of Law; established, re-established, monumented, re-monumented, recovered, found as expressed below:

**NOTE: Not more than 4 corners, all in the same town and range, may be recorded on this certificate.**

A. Description of original monument and accessories and/or subsequent restoration:

A-13: COMMON CORNER WITH A-1, T23N, R3E, SEE LCRC FOR THAT CORNER AND REMONUMENTATION DOSSIER FOR ADDITIONAL INFORMATION. CORNER APPROVED AT PEER REVIEW MEETING HELD ON DECEMBER 21, 1994

M-13: COMMON CORNER WITH M-1, T23N, R3E, SEE LCRC FOR THAT CORNER AND REMONUMENTATION DOSSIER FOR ADDITIONAL INFORMATION. CORNER APPROVED AT PEER REVIEW MEETING HELD ON DECEMBER 21, 1994

B. Description of corner evidence found and/or method applied in restoring or reestablishing corner:

A-13:

M-13:


C. Description of monument for corner and accessories established to perpetuate locating the position of the corner:

A-13:

M-13:

| A  | B  | C  | D  | E  | F  | G  | H | I | J | K | L | M |
|----|----|----|----|----|----|----|---|---|---|---|---|---|
| 2  | 6  | 5  | 4  | 3  | 2  | 1  |   |   |   |   |   |   |
| 3  |    |    |    |    |    |    |   |   |   |   |   |   |
| 4  | 7  | 8  | 9  | 10 | 11 | 12 |   |   |   |   |   |   |
| 5  |    |    |    |    |    |    |   |   |   |   |   |   |
| 6  | 16 | 17 | 18 | 15 | 14 | 13 |   |   |   |   |   |   |
| 7  |    |    |    |    |    |    |   |   |   |   |   |   |
| 8  | 19 | 20 | 21 | 22 | 23 | 24 |   |   |   |   |   |   |
| 9  |    |    |    |    |    |    |   |   |   |   |   |   |
| 10 | 30 | 29 | 28 | 27 | 26 | 25 |   |   |   |   |   |   |
| 11 |    |    |    |    |    |    |   |   |   |   |   |   |
| 12 | 31 | 32 | 33 | 34 | 35 | 36 |   |   |   |   |   |   |
| 13 |    |    |    |    |    |    |   |   |   |   |   |   |

Signed by

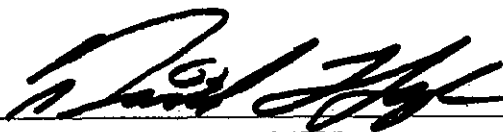

Date

12/29/94

Surveyor's Michigan License No. 27595

