

**SURVEY &
REMONUMENTATION**

MAY 03 1995

COMMISSION LAND CORNER RECORDATION CERTIFICATE
Filing Requirement of Act 74, Mich. P.A. 1970

For corners in
OGEMAW
(County)

Located In: Corner Code ##

- | | | | |
|---------------------------------------|---|----------------|-------------|
| 1. Public Land Survey | T | <u>24NR 3E</u> | <u>E-13</u> |
| | T | _____ R _____ | _____ |
| | T | _____ R _____ | _____ |
| | T | _____ R _____ | _____ |
| 2. Property Controlling
in Section | S | _____ T _____ | _____ |
| | S | _____ T _____ | _____ |
| 3. Miscellaneous
Property in Sec. | S | _____ T _____ | _____ |
| | S | _____ T _____ | _____ |
4. Lot No. _____, Recorded Plat _____
5. Private Claims _____

LISEK 2 PAGE 273

STATE OF MICHIGAN
OGEMAW COUNTY
RECORDED

3 JAN 95 9:39 A.M.

WANDA NUZIK
REGISTER OF DEEDS
Register of Deeds Stamp & File Number

A	B	C	D	E	F	G	H	I	J	K	L
2	6	5	4	3	2						
3											
4	7	8	9	10	11						
5											
6	18	17	16	15	14						
7											
8	19	20	21	22	23						
9											
10	30	29	28	27	26						
11											
12	31	32	33	34	35						
13											

I, Timothy L. Lapham, in a field survey on December, 19 94, do hereby certify that under requirements of P.A. 74, Michigan P.A. of 1970, the corner points mentioned in lines 1 and 2 above were in conformance with regulations and rules therefore as required in the current manual of survey instructions of the United States Department of the Interior, Bureau of Land Management or by a decree of a Court of Law and/or that the corner points mentioned in lines 3, 4 and 5 above were in conformance with the rules of the Michigan Board of Land Surveyors or by a Decree of a Court of Law; established, re-established, monumented, re-monumented, recovered, found as expressed below:

NOTE: Not more than 4 corners, all in the same town and range, may be recorded on this certificate.


A. Description of original monument and accessories and/or subsequent restoration:
E-13: GLO CLASON 1846, SET POST
HEMLOCK 18" N47E 27 LKS
HEMLOCK 11" N53W 22 LKS

B. Description of corner evidence found and/or method applied in restoring or reestablishing corner:
E-13: FOUND NO EVIDENCE OF ORIGINAL CORNER
SET CORNER AT GLO DISTANCE OF 9.90' WEST ALONG TOWNSHIP LINE FROM ESTABLISHED CORNER E1 T23N R3E
ACCEPTED ESTABLISHED POSITION AS BEST AVAILABLE EVIDENCE OF THE CORRECT POSITION OF THE ORIGINAL CORNER,

CORNER APPROVED AT PEER REVIEW MEETING HELD ON DECEMBER 21, 1994
SEE DOSSIER FOR ADDITIONAL INFORMATION

APPROVED BY PEER REVIEW	
12-21-94	<i>TL</i>
DATE	P.A. 345 of 1990

C. Description of monument for corner and accessories established to perpetuate locating the position of the corner:
E-13: SET 5/8"x36" REROD WITH 3-1/4" ALUMINUM OGEMAW REMON CAP IN MON BOX
N51E 44.10' 1/2" IRON BAR
EAST 9.90 REMON MONUMENT
S23E 30.72' NAIL IN POWER POLE
S49E 53.79' NAIL IN POWER POLE
N54W 55.95' NAIL IN 30" MAPLE
NORTH 1.0' CENTERLINE ROSE CITY ROAD

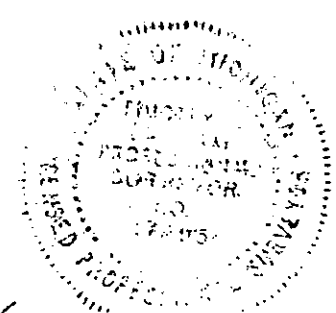

Signed by *Timothy L. Lapham*

Date 12/29/94

Surveyor's Michigan License No. 27595