

# SURVEY & REMONUMENTATION

MAY 0 3 1995

## LAND CORNER RECORDATION CERTIFICATE Filing Requirement of Act 74, Mich. P.A. 1970

### COMMISSION

For corners in  
OGEMAW

(County)

Located In:

Corner Code #

LIBER

2 PAGE 275

STATE OF MICHIGAN  
OGEMAW COUNTY  
RECORDED

3 JAN 95 9:44 A.M.

WANDA MUZIK  
REGISTER OF DEEDS  
Register of Deeds Stamp & File Number

- |                                       |                          |       |       |
|---------------------------------------|--------------------------|-------|-------|
| 1. Public Land Survey                 | T <u>24N</u> R <u>3E</u> | J-13  |       |
|                                       | T _____ R _____          | _____ | _____ |
|                                       | T _____ R _____          | _____ | _____ |
|                                       | T _____ R _____          | _____ | _____ |
| 2. Property Controlling<br>in Section | S _____ T _____ R _____  | _____ | _____ |
|                                       | S _____ T _____ R _____  | _____ | _____ |
| 3. Miscellaneous<br>Property in Sec.  | S _____ T _____ R _____  | _____ | _____ |
|                                       | S _____ T _____ R _____  | _____ | _____ |

4. Lot No. \_\_\_\_\_, Recorded Plat \_\_\_\_\_
5. Private Claims \_\_\_\_\_

	A	B	C	D	E	F	G	H	I	J	K	L
2	6	5	4	3	2							
3												
4	7	8	9	10	11							
5												
6	18	17	16	15	14							
7												
8	19	20	21	22	23							
9												
10	30	29	28	27	26							
11												
12	31	32	33	34	35							
13												

I, Timothy L. Lapham, in a field survey on December, 19 94, do hereby certify that under requirements of P.A. 74, Michigan P.A. of 1970, the corner points mentioned in lines 1 and 2 above were in conformance with regulations and rules therefore as required in the current manual of survey instructions of the United States Department of the Interior, Bureau of Land Management or by a decree of a Court of Law and/or that the corner points mentioned in lines 3, 4 and 5 above were in conformance with the rules of the Michigan Board of Land Surveyors or by a Decree of a Court of Law; established, re-established, monumented, re-monumented, recovered, found as expressed below:

**NOTE: Not more than 4 corners, all in the same town and range, may be recorded on this certificate.**

A. Description of original monument and accessories and/or subsequent restoration:  
J-13: GLO CLASON 1846, SET POST

HEMLOCK 12" N68E 22LKS  
HEMLOCK 10" N14W 35LKS

1945 SHADKO (DNR) FOUND OLD STAKE PLACED MONUMENT, 1-1/4" PIPE N3-1/2E 33', NORWAY 14" S22W 69.5', JACKPINE 12" N4-30W 68.9', JACK PINE 11" N57E 95.5'  
CALDWELL SURVEY 3-137 SEPT 1979, NO CORNER MAT, NO WITS

B. Description of corner evidence found and/or method applied in restoring or reestablishing corner:  
J-13: FOUND 1/2" IRON AND PIPE NORTH

CORNER AGREES WITH GLO CALLS TO STREAM WEST AND TO RIDGE EAST & WEST  
ACCEPTED FOUND CORNER AS BEST AVAILABLE EVIDENCE TO THE POSITION OF THE ORIGINAL CORNER  
CORNER APPROVED AT PEER REVIEW MEETING HELD DECEMBER 21, 1994  
SEE DOSSIER FOR ADDITIONAL INFORMATION


APPROVED BY  
PEER REVIEW

12-21-94 *TL*

DATE P.A. 345 of 1990

C. Description of monument for corner and accessories established to perpetuate locating the position of the corner:  
J-13: SET 5/8"x36" REROD WITH 3-1/4" ALUMINUM OGEMAW REMON CAP IN MON BOX

N67E 83.72' SET SPIKE IN 10" JACK PINE  
S29E 60.02' SET SPIKE IN 6" RED PINE  
S30W 39.98' SET SPIKE IN 4" TAMARACK  
N32W 42.88' SET SPIKE IN 10" JACK PINE  
EAST 14.04' REMON MONUMENT, J-1 T23N R3E

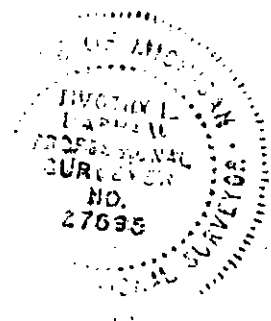

Signed by \_\_\_\_\_

Date 12/25/94

Surveyor's Michigan License No. 27595