

SURVEY & REMONUMENTATION

MAY 03 1995

LAND CORNER RECORDATION CERTIFICATE Filing Requirement of Act 74, Mich. P.A. 1970

For corners in COMMISSION
Ogemaw
(County)

Located In: _____ Corner Code # _____

- | | | | |
|---------------------------------------|--------------------------|-------|-------|
| 1. Public Land Survey | T <u>24N</u> R <u>3E</u> | K-13 | |
| | T _____ R _____ | _____ | _____ |
| | T _____ R _____ | _____ | _____ |
| | T _____ R _____ | _____ | _____ |
| 2. Property Controlling in Section | S _____ T _____ R _____ | _____ | _____ |
| | S _____ T _____ R _____ | _____ | _____ |
| 3. Miscellaneous Property in Sec. | S _____ T _____ R _____ | _____ | _____ |
| | S _____ T _____ R _____ | _____ | _____ |
| 4. Lot No. _____, Recorded Plat _____ | | | |
| 5. Private Claims _____ | | | |

LIBER 2 PAGE 276

STATE OF MICHIGAN
OGEMAW COUNTY
RECORDED

3 JAN 95 9:44 A.M.

MANDA MUZIK
REGISTER OF DEEDS
Register of Deeds Stamp & File Number

	A	B	C	D	E	F	G	H	I	J	K	L
2	6		5		4		3		2			
3												
4	7		8		9		10		11			
5												
6	18		17		16		15		14			
7												
8	19		20		21		22		23			
9												
10	30		29		28		27		26			
11												
12	31		32		33		34		35			
13												

I, Timothy L. Lapham, in a field survey on December, 19 94, do hereby certify that under requirements of P.A. 74, Michigan P.A. of 1970, the corner points mentioned in lines 1 and 2 above were in conformance with regulations and rules therefore as required in the current manual of survey instructions of the United States Department of the Interior, Bureau of Land Management or by a decree of a Court of Law and/or that the corner points mentioned in lines 3, 4 and 5 above were in conformance with the rules of the Michigan Board of Land Surveyors or by a Decree of a Court of Law; established, re-established, monumented, re-monumented, recovered, found as expressed below:

NOTE: Not more than 4 corners, all in the same town and range, may be recorded on this certificate.

A. Description of original monument and accessories and/or subsequent restoration:
K-13: GLO CLASON 1848, SET POST

W. PINE 10" N24E 11LKS
W. PINE 16" N40W 38LKS

1945 SHADKO (DNR) SURVEY, FOUND 1" PIPE AND PLACED STANDARD MONUMENT, 3 WITNESSES (PRESUMED TO BE COMMON STANDARD AND CLOSING CORNERS IN SURVEY)
CALDWELL SURVEYS 1-276 MARCH 1973, 3-140 AUG 1979, 3-137 SEPT 1979, 3-253 APRIL 1980, NO CORNER MAT, NO WITS
LAPHAM LCRC 2-173 JAN 1993 FND CAPPED IRON, 3 WITS

B. Description of corner evidence found and/or method applied in restoring or reestablishing corner:

K-13: FOUND UNLEGIBLE CAPPED IRON AT INTERSECTION OF EAST WEST ROAD AND ROAD NORTH
FOUND 2 OF LAPHAM 2-173 RECORDED WITNESSES, DISTANCE EAST AND WEST AGREE WITH RECORDED SURVEYS
ACCEPTED FOUND CORNER AS BEST AVAILABLE EVIDENCE OF THE POSITION OF THE ORIGINAL CORNER

CORNER APPROVED AT PEER REVIEW MEETING HELD DECEMBER 21, 1994
SEE DOSSIER FOR ADDITIONAL INFORMATION


APPROVED BY
PEER REVIEW

12-21-94 TL

DATE P.A. 345 of 1990

C. Description of monument for corner and accessories established to perpetuate locating the position of the corner:

K-13: SET 5/8"x36" REROD WITH 3-1/4" ALUMINUM OGEMAW REMON CAP IN MON BOX
N12E 134.73' SET SPIKE IN 16" OAK
S37E 51.06' SPIKE IN POWER POLE
S11W 77.05' USGS BENCHMARK
S51W 51.91' SPIKE IN CEDAR POST
EAST 11.89' REMON MONUMENT K-1 T23N R3E

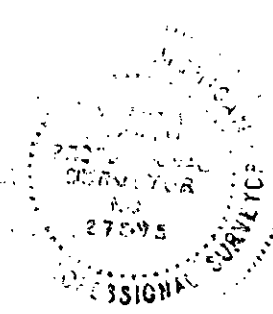

Signed by *Timothy L. Lapham*

Date 12/27/94

Surveyor's Michigan License No. 27595