

LAND CORNER RECORDATION CERTIFICATE

FILING REQUIREMENT OF ACT 74, MICH. P.A.1970

FOR CORNERS OF--:	LOCATED IN--:	CORNER CODE NUMBER
1. PUBLIC LAND SURVEY _____	T. 17 N. ● R. 7 W. ●	A-5; A-7
2. PROPERTY CONTROLLING IN SECTION _____	T. _____ N. S. R. E. W.	_____
3. MISCELLANEOUS PROPERTY IN SECTION _____	T. _____ N. S. R. E. W.	_____
4. LOT NO. _____, RECORDED PLAT _____		
5. PRIVATE CLAIMS _____		

REGISTER OF DEEDS STAMP AND FILING NUMBER

I, Carl F. Roser, do hereby certify that under requirements of P.A. 74, Michigan P.A. of 1970, the corner points mentioned in lines 1 and 2 above were, in a field survey on March 17, 1976, established, re-established, monumented, re-monumented, recovered or restored as expressed below and in conformance with regulations and rules therefore as required in the current manual of survey instructions of the United States Department of the Interior, Bureau of Land Management or by a decree of a court of law. Furthermore, that the corner points mentioned in lines 3, 4 and 5 above were, in a field survey on _____, 19____, found, recovered, restored, established or re-established as expressed below and in conformance with the rules of the Michigan State Board of Registration for Land Surveyors or, by a Decree of a Court of law:

A. Description of original monument and accessories and/or subsequent restoration:

B. Description of corner evidence found and/or method applied in restoring or re-establishing corner:


- A-5 Found 2" square stake & small stones & iron that fits two McClung witnesses. Corner falls in center of N-S gravel road; is in line with fence to E & is 5' S. of old township road grade to W.
- A-7 Recovered iron from two McClung witnesses. Corner is 3' south of center of blacktop road W & gravel road E and in line with gravel road to N.

C. Description of monument for corner and accessories established to perpetuate locating the position of the corner:

	A-5		A-7	
Found stake, stones & small iron; added 3/4" x 12" rod			Found 1"x1" square-head iron	
Power Pole S30 ^{OW}	86.62		29" Oak N35 ^{OE}	59.10
5" W. Birch N65 ^{OW}	47.07		24" Maple S25 ^{OE}	98.82

SIGNED BY Carl F. Roser 9-15-76 DATE _____

SURVEYOR'S MICHIGAN REGISTRATION NO. 12028

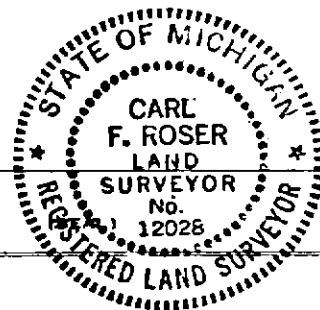

FOR STATE AND UNITED STATES AGENCIES:

SIGNED BY _____ DATE _____
CHIEF OF SURVEY PARTY

APPROVED AND SIGNED BY _____ DATE _____
MICHIGAN REGISTERED LAND SURVEYOR

(SEAL)

SURVEYOR'S MICHIGAN REGISTRATION NO. _____ ORIENT TOWNSHIP
 OSCEOLA COUNTY