

**SURVEY &
REMONUMENTATION**

AUG 23 1995

LAND CORNER RECORDATION CERTIFICATE
Filing Requirement of Act 74, Mich. P.A. 1970

For corners in Osceola
(County) **COMMISSION**

	Located In:	Corner Code #
1. Public Land Survey	17N 7W	E-5
	T ___ R ___	_____
	T ___ R ___	_____
	T ___ R ___	_____
	T ___ R ___	_____
2. Property Controlling in Section	S ___ T ___ R ___	_____
	S ___ T ___ R ___	_____
3. Miscellaneous Property in Sec.	S ___ T ___ R ___	_____
	S ___ T ___ R ___	_____

APPROVED LAND CORNER
P.A. 345 OF 1990
Osceola County

29 June 1995
Matthew McClung

Register of Deeds Stamp & File Number

4. Lot No. _____, Recorded Plat _____
5. Private Claims _____

Matthew McClung June 13 95
I, _____, in a field survey on _____, 19 _____,

do hereby certify that under requirements of P.A. 74, Michigan P.A. of 1970, the corner points mentioned in lines 1 and 2 above were in conformance with regulations and rules therefore as required in the current manual of survey instructions of the United States Department of the Interior, Bureau of Land Management or by a decree of a Court of Law and/or that the corner points mentioned in lines 3, 4 and 5 above were in conformance with the rules of the Michigan Board of Land Surveyors or by a Decree of a Court of Law, established, re-established, monumented, re-monumented, recovered, found as expressed below:

NOTE: Not more than 4 corners, all in the same town and range, may be recorded on this certificate.

A. Description of original monument and accessories and/or subsequent restoration:

The original corner was set by deputy surveyor Orson Lyons on 6 January 1848. Set wood post at 80.00 chains from South.
Beech 8" S441/2W 13 lks.
Beech 8" S82E 17 lks.

From 1891 to 1904 approximately, Osceola County had a remonumentation program, in which surveyors Temple and Trumbull, did the work. For the most part, a 3" glazed tile filled with cinders from a forge, were placed at each government set corner in the township. There were supposed to be 3 tile per corner, placed atop of each other. (continued on back)

B. Description of corner evidence found and/or method applied in restoring or reestablishing corner.

Found cement nail at surface 14" S60E from final corner. Found wagon hub 2" deep, noted as 3" pipe (in county survey records) N30W 4" from final corner. Found stone 3" below 18" long 4"x6" rectangular in shape, narrowing to a blunt point on top, 3" North from corner. Found 3" tile 11" below surface. Place Osceola County Monument in center of tile, 6" below surface.

C. Description of monument for corner and accessories established to perpetuate locating the position of the corner.


Corner E-5 . Osceola County Monument, which is a 3" brass cap mounted on a 1" pipe 18" in length.
22" Maple N66W 76.96 feet.
Power Pole S24E 88.90 feet.
Telephone Riser N34W 44.03 feet.
Cement Fence Post N38W feet.

O.B.T. 24" Elm N55W 65.2 feet. Found old bearing tree stump, badly rotted, and measured 66.43 feet to stump.

Signed by *Matthew McClung*

Date June 13, 1995

Surveyor's Michigan License No. 13037

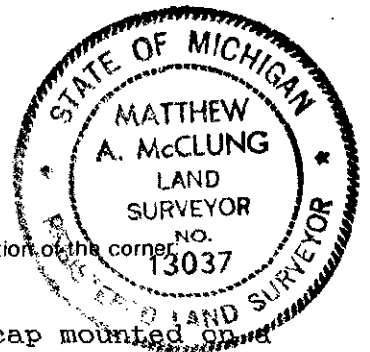

FORM APPROVED BY MICHIGAN STATE BOARD OF LAND SURVEYORS, JAN. 28, 1971
REVISED MAY 14, 1975
REVISED JAN., 1983

OSCEOLA COUNTY
REGISTER OF DEEDS

95 JUL -6 AM 10:40

Nancy Crawford

thereby making the corner 4 feet long. Sometimes a solid tile, with a cross in the top was used, and sometimes a 1/2" iron bars were added to the tile. Notes of the work were kept in ledgers, and given to the townships, and 5 of the townships have been recorded in the County records.

County records of Orient Township book, pages 40 and 41, front page No. 1 1/3 from the top. First note is from front cover.