

SURVEY &
REMONUMENTATION

NOV 01 1999

LAND CORNER RECORDATION CERTIFICATE
Filing Requirement of Act 74, Mich. P.A. 1970

SECTION

For corners in
Osceola

(County)

| Located In: | Corner Code # |
|--------------------------|---------------|
| T <u>17</u> N <u>7</u> W | H-3 |
| T _____ R _____ | _____ |
| T _____ R _____ | _____ |
| T _____ R _____ | _____ |
| T _____ R _____ | _____ |
| S _____ T _____ R _____ | _____ |
| S _____ T _____ R _____ | _____ |
| S _____ T _____ R _____ | _____ |
| S _____ T _____ R _____ | _____ |

1. Public Land Survey

2. Property Controlling
in Section

3. Miscellaneous
Property in Sec.

Register of Deeds Stamp & File Number

4. Lot No. _____, Recorded Plat _____
5. Private Claims _____

I, Robert L. Wetherell, in a field survey on Aug 9, 1999 do hereby state that under requirements of P.A. 74, Michigan P.A. of 1970, the corner points mentioned in lines 1 and 2 above were in conformance with regulations and rules therefore as required in the current manual of survey instructions of the United States Department of the Interior, Bureau of Land Management or by a decree of a Court of Law and /or that the corner points mentioned in lines 3, 4 and 5 above were in conformance with the rules of the Michigan Board of Land Surveyors or by a Decree of a Court of Law; established, re-established, monumented, recovered, found as expressed below:

NOTE: Not more than 2 corners, all in the same town and range, may be recorded on this certificate.

H-3 - N¼ Corner of Section 10, T17N, R7W

| | A | B | C | D | E | F | G | H | I | J | K | L | M |
|----|---|----|---|----|---|----|---|----|---|----|---|----|---|
| 1 | | | | | | | | | | | | | |
| 2 | | 6 | | 5 | | 4 | | 3 | | 2 | | 1 | |
| 3 | | | | | | | | ● | | | | | |
| 4 | | 7 | | 8 | | 9 | | 10 | | 11 | | 12 | |
| 5 | | | | | | | | | | | | | |
| 6 | | 18 | | 17 | | 16 | | 15 | | 14 | | 13 | |
| 7 | | | | | | | | | | | | | |
| 8 | | 19 | | 20 | | 21 | | 22 | | 23 | | 24 | |
| 9 | | | | | | | | | | | | | |
| 10 | | 30 | | 29 | | 28 | | 27 | | 26 | | 25 | |
| 11 | | | | | | | | | | | | | |
| 12 | | 31 | | 32 | | 33 | | 34 | | 35 | | 36 | |
| 13 | | | | | | | | | | | | | |

A. Description of original monument and accessories and/or subsequent restoration:

1848 - O. Lyon

#1 - 4" Spruce S09W 6 Links
#2 - 3" Spruce N27½E 53 Links

1891 - 1904 - A. Temple/F. Trumbull

Remonumentation of T17N, R7W
Set 3" Clay tiles
"Stake"
#3 - 9" Tamarack stump N75½E 65 Lks.
#4 - 8" Fence Post N3½E 46¼ Lks.

(SEE OVER FOR CONTINUATION OF "A")

B. Description of corner evidence found and/or method applied in restoring or reestablishing corner:

Found 5/8" Iron with capped marker # 13037 that fits well with 1977 accessories by Lapham.

Condition of the accessories are as follows: #1 Gone, #2 Gone, #3 Gone, #4 Gone, #5 Fd. stump, #6 Found, #7 Gone and #8Gone.

C. Description of monument for corner and accessories established to perpetuate locating the position of the corner:

I replaced the 5/8" capped iron with and Osceola County Monument (1½" pipe with an Osceola County Remon Cap and is accepted as a substantial marker for the corner and is accepted as a careful and faithful re-establishment of the position of the original corner


22" Willow Stump (Nail on S. side) N82E 77.05' #5
12" B. Willow (Nail on S. side) N74E 162.47'
9" B. Willow (Nail on S. side) N70W 121.65'
10" B. Willow (Nail on S. side) N66W 102.30'

Distance to NE Corner 2623.35'
Distance to NW Corner 2634.86', M. McClung's distances

Signed by Robert L. Wetherell 24624

Date 8-26-99

Surveyor's Michigan License No. _____
APPROVED LAND CORNER
P.A. 345 OF 1990
Osceola County

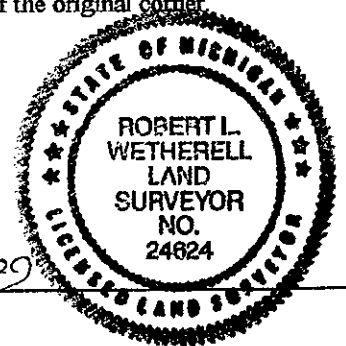

8-26-99
R. L. W.

CONTINUATION OF DESCRIPTION OF ORIGINAL MONUMENT AND ACCESSORIES AND/OR SUBSEQUENT RETORATION.

1977 - Lapham LS 9433

LCRC
L.2, Pg 137
Set 1/2" Re-Rod
#5 - 10" Willow N80E 78.70'
#6 - 2" Pipe Cor. Post N15E 34.40'
#7 - Corner Post S15E 34.10'
#8 - 3" Elm S30E 25.55'

1998 Wetherell LS 24624

Fd. Capped iron by McClung
Broke Sec 3. And showed the following
Distances: To SW Corner of Sec 3 - 2635.10'
Distances: To SE Corner of Sec 3 - 2623.20'

Wacey Campbell
99 SEP - 3 AM 11:48
OSCEOLA COUNTY
REGISTER OF DEEDS

SURVEY &
REMONUMENTATION

NOV 01 1999

SECTION