

FEB 24 2000

SECTION

LAND CORNER RECORDATION CERTIFICATE

FILING REQUIREMENT OF ACT 74, Mich. P.A. 1970

For corners in Osceola

Located in: Corner Code#

- 1. Public Land Survey T17N R7W I-5
2. Property Controlling in Section
3. Miscellaneous Property in Sec.
4. Lot No. Recorded Plat
5. Private Claims

OSCEOLA COUNTY REGISTER OF DEEDS 99 NOV 19 PM 12: 09

Register of Deeds Stamp & File Number

I, Robert L. Wetherell, in a field survey on October 9, 1999, do hereby certify that under requirements of P.A. 74, Michigan P.A. of 1970, the corner points mentioned in lines 1 and 2 above were in conformance with regulations and rules therefore as required in the current manual of survey instructions of the United States Department of the Interior, Bureau of Land Management or by decree of a Court of Law and/or that the corner points mentioned in lines 3, 4, and 5 above were in conformance with the rules of the Michigan Board of Land Surveyors or by a Decree Of a Court of Law; established, re-established, monumented, re-monumented, recovered, found as expressed below:

Grid table with columns A-K-L-M and rows 1-13. Values include 6, 5, 4, 3, 2, 1, 7, 8, 9, 10, 11, 12, 18, 17, 16, 15, 14, 13, 19, 20, 21, 22, 23, 24, 30, 29, 28, 27, 26, 25, 31, 32, 33, 34, 35, 36.

I-5 - Section corner common to Sections 10, 11, 14 & 15, T17N, R7W, Osceola Co., Mi.

A. Description of original monument and accessories and/or subsequent restoration:

1848 - O. Lyon, G.L.O. #1 - 18" Maple N4°W 27 Links #2 - 16" Birch S45°E 24 Links Temple/Trumbull "Identified by stake and O.B.T." #3 - 48" Pinc Stump S20 1/2°E 157 1/2 Links Set 3" Clay Tile

1973 - D. Verba, LS 13603 L.C.R.C. - Liber 01, Page 212 Found Stone with cross on top. #4 - 5" Poplar AZ 18° 55.29' #5 - 5" Poplar AZ 58° 37.96' #6 - 8" Oak AZ 251° 22.68' 1977 - P. Lapham, LS 09433 L.C.R.C. - Liber 02, Pg. 212 "X" on Square Rock. #6 - 10" Oak S75°W 23.57' #7 - 4" Maple N20°E 34.45' #8 - 8" Maple N30°W 34.50' #9 - 4" Maple - South 54.55'

1987 - P. Lapham, LS 09433 L.C.R.C. - Liber 02, Pg. 280 Survey recorded L. 484, Pg. 598. Same witnesses as recorded in 1977. 1998 - Matt McClung, LS 13037 Survey recorded Liber 645, Pg. 114. Rock with chiseled "X" #10 - 8" Cherry N8°W 34.6' #7 - 8" Maple N40°E 34.45' #9 - 6" Maple S16°E 54.5' #11 - 6" Maple S84°W 16.25'


B. Description of corner evidence found and/or method applied in restoring of reestablishing corner:

I found a square rock with "X" on top. I also found the 3" Clay tile 3.10 feet south of rock. I accepted the 3" Clay Tile as the correct corner. Condition of the accessories are as follows: #1 Gone, #2 Gone, #3 Found in poor condition, #4 gone, #5 Found Stump, #6 Gone, #7 Gone, #8 Gone, #9 Found in good condition, #10, Found in bad condition, #11 Found in good condition.

C. Description of monument for corner and accessories established to perpetuate locating the position of the corner:

I placed a 1" x 18" pipe with Osceola County Cap, and is accepted as a careful and faithful perpetuation of the position of the original corner. 9" Maple S32°E 48.75' (Nail in W. side) 8" Maple N65°W 16.40' (Nail in S. side) 8" Maple N45°E 37.23' (Nail in N.W. side) 8" Maple S5°W 51.34' (Nail in E. side) "X" on Stone N10°E 3.10'

APPROVED LAND CORNER P.A. 245 OF 1990 Osceola County 10-21-99 R.L.W.

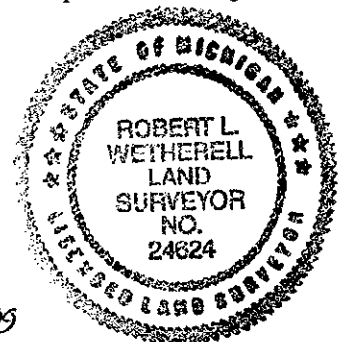

Signed by Robert L. Wetherell Surveyor's Michigan License No. 24624

Date Nov. 9, 1999