

NOV 15 1994

COMMISSION

LAND CORNER RECORDATION CERTIFICATE
Filing Requirement of Act 74, Mich. P.A. 1970

For corners in

Osceola
(County)

Located In:

Corner Code #

- 1. Public Land Survey T 17N R 7W K-5
T _____ R _____
T _____ R _____
T _____ R _____
- 2. Property Controlling S _____ T _____ R _____
in Section S _____ T _____ R _____
- 3. Miscellaneous S _____ T _____ R _____
Property in Sec. S _____ T _____ R _____

APPROVED LAND CORNER
P.A. 345 OF 1990
Osceola County

Matthew McClung
October 11, 1994

Register of Deeds Stamp & File Number

- 4. Lot No. _____, Recorded Plat _____
- 5. Private Claims _____

	A	B	C	D	E	F	G	H	I	J	K	L	M
2	6	5	4	3	2								
3													
4	7	8	9	10	11	12							
5													
6	18	17	16	15	14	13							
7													
8	19	20	21	22	23	24							
9													
10	30	29	28	27	26	25							
11													
12	31	32	33	34	35	36							
13													

I, Matthew McClung in a field survey on October 3, 1994, do hereby certify that under requirements of P.A. 74, Michigan P.A. of 1970, the corner points mentioned in lines 1 and 2 above were in conformance with regulations and rules therefore as required in the current manual of survey instructions of the United States Department of the Interior, Bureau of Land Management or by a decree of a Court of Law and/or that the corner points mentioned in lines 3, 4 and 5 above were in conformance with the rules of the Michigan Board of Land Surveyors or by a Decree of a Court of Law; established, re-established, monumented, re-monumented, recovered, found as expressed below:

NOTE: Not more than 4 corners, all in the same town and range, may be recorded on this certificate.

A. Description of original monument and accessories and/or subsequent restoration:

The original corner was set by deputy surveyor Orson Lyons on 14 April 1847. Set wood post 80 chains from south.
Hemlock 12" S46W 22 lks.
Hemlock 13" N31E 21 lks.


From 1891 to 1904 approximately, Osceola County had a remonumentation program, in which surveyors Temple and Trumbull, did the work. For the most part, a 3" glazed tile filled with cinders from a forge, were placed at each government set corner in the township. There were supposed to be 3 tile per corner, placed atop of each other, (continued on back)

B. Description of corner evidence found and/or method applied in restoring or reestablishing corner:

Found "T" iron at road surface, which is a steel fence post. Found tile at 8" below road surface. Placed Osceola County Monument 6" below road surface in center of tile. Broke "T" iron off below monument. Corner is in "T" intersection.

C. Description of monument for corner and accessories established to perpetuate locating the position of the corner:

Corner G-11. Osceola County Monument, which is a 3" brass cap mounted on 1" pipe 18" in length.
16" Maple S45W 46.75 feet. O.B.T.
Telephone Pedestal S83W 34.2 feet.
18" Maple S30W 110.0 feet.
Gas Well S40E 182.75 feet.

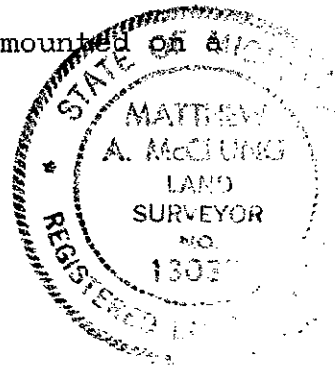

Signed by Matthew McClung
Surveyor's Michigan License No. 13037

Date October 3, 1994

OSCEOLA COUNTY
REGISTER OF DEEDS

94 NOV -4 PM 2:48

Nancy Crawford

thereby making the corner 4 feet long. Sometimes a solid tile, with a cross in the top was used, and sometimes a 1/2" iron bars were added to the tile. Notes of the work were kept in ledgers, and given to the townships, and 5 of the townships have been recorded in the County records.

This corner has 2 LCRC.s Liber 1, Page 118, by Verba and 2, 280 by Lapham.

3 PA 132 documents, Liber 300, page 621 - 454,560 - 346, 146.

Recorded in Township book on page 36.

SURVEY &
REMONUMENTATION

NOV 15 1994

COMMISSION