

NOV 15 1994

COMMISSION

LAND CORNER RECORDATION CERTIFICATE  
Filing Requirement of Act 74, Mich. P.A. 1970

For corners in

Osceola  
(County)

Located In:

Corner Code #

- 1. Public Land Survey T 17N R 7W K-8  
T \_\_\_\_\_ R \_\_\_\_\_  
T \_\_\_\_\_ R \_\_\_\_\_  
T \_\_\_\_\_ R \_\_\_\_\_
- 2. Property Controlling S \_\_\_\_\_ T \_\_\_\_\_ R \_\_\_\_\_  
in Section S \_\_\_\_\_ T \_\_\_\_\_ R \_\_\_\_\_
- 3. Miscellaneous S \_\_\_\_\_ T \_\_\_\_\_ R \_\_\_\_\_  
Property in Sec. S \_\_\_\_\_ T \_\_\_\_\_ R \_\_\_\_\_

APPROVED LAND CORNER  
P.A. 345 OF 1990  
Osceola County

*Matthew McClung*  
October 11, 1994

Register of Deeds Stamp & File Number

- 4. Lot No. \_\_\_\_\_, Recorded Plat \_\_\_\_\_
- 5. Private Claims \_\_\_\_\_

	A	B	C	D	E	F	G	H	I	J	K	L	M
2	6	5	4	3	2	1							
3													
4	7	8	9	10	11	12							
5													
6	18	17	16	15	14	13							
7													
8	19	20	21	22	23	24							
9													
10	30	29	28	27	26	25							
11													
12	31	32	33	34	35	36							
13													

I, Matthew McClung in a field survey on October 4, 1994, do hereby certify that under requirements of P.A. 74, Michigan P.A. of 1970, the corner points mentioned in lines 1 and 2 above were in conformance with regulations and rules therefore as required in the current manual of survey instructions of the United States Department of the Interior, Bureau of Land Management or by a decree of a Court of Law and/or that the corner points mentioned in lines 3, 4 and 5 above were in conformance with the rules of the Michigan Board of Land Surveyors or by a Decree of a Court of Law; established, re-established, monumented, re-monumented, recovered, found as expressed below:

NOTE: Not more than 4 corners, all in the same town and range, may be recorded on this certificate.


A. Description of original monument and accessories and/or subsequent restoration:

The original corner was set by deputy surveyor Orson Lyons on 14 April 1848. Set wood post at 40.00 chains from South.  
Hemlock 14" N35E 35 lks.  
Hemlock 15" N35W 10 lks.

From 1891 to 1904 approximately, Osceola County had a remonumentation program, in which surveyors Temple and Trumbull, did the work. For the most part, a 3" glazed tile filled with cinders from a forge, were placed at each government set corner in the township. There were supposed to be 3 tile per corner, placed atop of each other. (continued on back)

B. Description of corner evidence found and/or method applied in restoring or reestablishing corner:

Found 5/8" iron rod inside tile 11" below road surface. Placed Osceola County Monument over rod and inside tile, 6" below road surface.

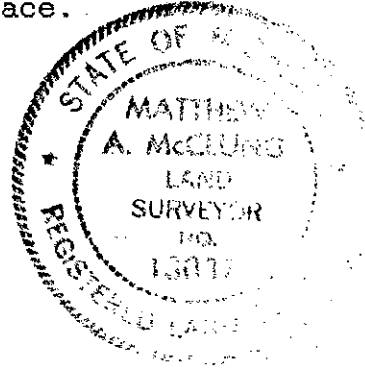

C. Description of monument for corner and accessories established to perpetuate locating the position of the corner:

Corner K-10. Osceola County Monument, which is a 3" brass cap mounted on a 1" pipe 18" in length.  
10" R. Pine, spike south side, N80W 45.67 feet. O.B.T.  
9" R. Pine, spike South side, N70W 51.87 feet. O.B.T.  
Rail road tie fence post East 31.43 feet. O.B.P.  
6" Black Oak, Spike South Side, S60W 42.77 feet. O.B.T.

Signed by Matthew McClung Date October 4, 1994  
Surveyor's Michigan License No. 13037

OSCEOLA COUNTY  
REGISTER OF DEEDS

94 NOV -4 PM 2:47

*Nancy Crawford*

thereby making the corner 4 feet long. Sometimes a solid tile, with a cross in the top was used, and sometimes a 1/2" iron bars were added to the tile. Notes of the work were kept in ledgers, and given to the townships, and 5 of the townships have been recorded in the County records.

An unrecorded survey by Norman Ochs with witnesses.

SURVEY &  
REMONUMENTATION

NOV 15 1994

COMMISSION