


LAND CORNER RECORDATION CERTIFICATE
Filing Requirement of Act 74, Mich. P.A. 1970

For corners in

<u>Osceola</u> <small>(County)</small>	Located In:	Corner Code #
1. Public Land Survey	T 17N R 8W	B-3
2. Property Controlling in Section	S T R	
3. Miscellaneous Property in Sec.	S T R	

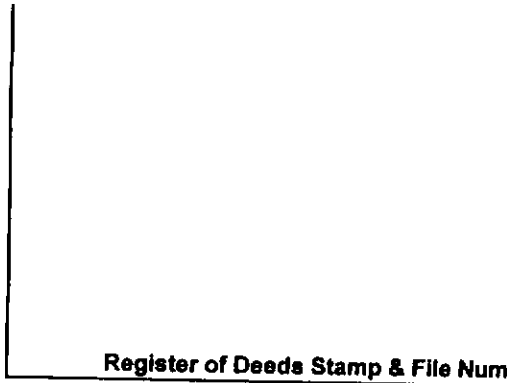

4. Lot No. _____, Recorded Plat _____

5. Private Claims _____

I, Craig W. McVean, in a field survey on March 30, 19 98 do hereby state that under requirements of P.A. 74, Michigan P.A. of 1970, the corner points mentioned in lines 1 and 2 above were in conformance with regulations and rules therefore as required in the current manual of survey instructions of the United States Department of the Interior, Bureau of Land Management or by a decree of a Court of Law and /or that the corner points mentioned in lines 3, 4 and 5 above were in conformance with the rules of the Michigan Board of Land Surveyors or by a Decree of a Court of Law; established, re-established, monumented, recovered, found as expressed below:

A	B	C	D	E	F	G	H	I	J	K	L	M
1												
2	6		5		4		3		2		1	
3	•											
4	7		8		9		10		11		12	
5												
6	18		17		16		15		14		13	
7												
8	19		20		21		22		23		24	
9												
10	30		29		28		27		26		25	
11												
12	31		32		33		34		35		36	
13												

NOTE: Not more than 2 corners, all in the same town and range, may be recorded on this certificate.

A. Description of original monument and accessories and/or subsequent restoration:

- B-3** - GLO - Set post - Orson Lyon - 1847
 Beech 12" N17°E 5L.
 Beech 10" S3°W 20L.
- Lyman W. June - 1890 - stone w/crockery.
- Frank Trumbull - 1900 + Stone & Iron Grate - Set iron and tile mon.
 Pine stump 30" N 11 1/2°E 77 1/2 L.
 Pine stump 20" N44°E 65 L.
- LCRC - L. 1, P. 181 - Wm. Batzer - 1973
 FND 2" x 3" Iron Bar
 S49°E 50.03' - 12" Oak
 North 32.12' - 3/4" Iron Bar
 N86°W 156.51' - 14" Oak
 S67° W 103.15' - Telephone Pole
- LCRC - L. 1, P. 377 - Matt McClung - 1975
 FND Iron Bar - Set Brass Cap
 12" W. Oak S50°E 49.45'
 Stone S30°W 28.55'
- Rec. Sur. - L. 326, P. 155 - Matt McClung - 1976
 FND. Iron Bar
- DNR Proj. #75-44 - K. J. Ostling
 FND 2" x 3" Iron Post - 1977
- Rec. Sur. - L. 515, P. 18 - Gerald Gray - 1989
 FND. Brass Cap

B. Description of corner evidence found and/or method applied in restoring or reestablishing corner:

- B-3** - 1/4 Corner common to Sec. 6 & Sec. 7, T17N, R8W. FND 3" dia. Vit tile down 1.2' with 2" x 3" Iron Post 0.32' NW - down 0.5'. Also FND, stone on N. side and white pieces of crockery around 3" dia. Vit. tile. Didn't find Brass Cap. Monument falls in CL of E-W Gravel Rd. Fence line N. Accepted tile Mon. as a careful and faithful perpetuation of the position of original corner.

C. Description of monument for corner and accessories established to perpetuate locating the position of the corner:

- B-3** - Drove 2" A.C. on 5/8" x 34" Rebar in center of 3" dia. Vit. Tile Mon.
 Built Ring of Stone w/Conc. - down 0.5'.
 S 38°W 29.60' to chisled 'X' on high point of boulder - (MM).
 *S 55°E 49.92' to Set N&T in NE side 18" W. Oak (MM, WB).
 N 2°E 32.36' to 3/4" Iron Rod. (WB).
 S 4°W 204.37' to NE Corner block foundation of house #11509.
 N 78°W 156.74' to Set N&T in S. Side 32" W. Oak (WB).

*Old nail above.



Signed by Craig W. McVean
 Surveyor's Michigan License No. 39088

Date 4/27/1998