

**SURVEY & REMONUMENTATION**


DEC 13 2000

**SECTION**

**LAND CORNER RECORDATION CERTIFICATE**

FILING REQUIREMENT OF ACT 74, Mich. P.A. 1970

For corners in <u>Osceola</u>	Located in:	Corner Code#
1. Public Land Survey	T 17 N    R 8 W    C-8	
	T            R	
	T            R	
	T            R	
2. Property Controlling S    T            R in Section		
	S    T            R	
3. Miscellaneous S    T            R Property in Sec.		
	S    T            R	
4. Lot No. _____ Recorded Plat _____		
5. Private Claims _____		

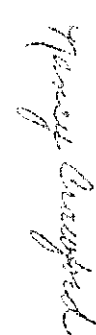  
**OSCEOLA COUNTY**  
**REGISTER OF DEEDS**  
**00 MAY -5 PM 2:50**  
 Register of Deeds Stamp & File Number

I, Robert L. Wetherell, in a field survey on March 22, 2000, do hereby certify that under requirements of P.A. 74, Michigan P.A. of 1970, the corner points mentioned in lines 1 and 2 above were in conformance with regulations and rules therefore as required in the current manual of survey instructions of the United States Department of the Interior, Bureau of Land Management or by decree of a Court of Law and/or that the corner points mentioned in lines 3, 4, and 5 above were in conformance with the rules of the Michigan Board of Land Surveyors or by a Decree Of a Court of Law; established, re-established, monumented, re-monumented, recovered, found as expressed below:

	A	B	C	D	E	F	G	H	I	J	K	L	M
1													
2	6	5	4	3	2	1							
3													
4	7	8	9	10	11	12							
5													
6	18	17	16	15	14	13							
7													
8	19	20	21	22	23	24							
9													
10	30	29	28	27	26	25							
11													
12	31	32	33	34	35	36							
13													

**C-8 - 1/4 Corner common to Sections 19 & 20, T17N, R8W**

**A. Description of original monument and accessories and/or subsequent restoration:**

**1848 - O. Lyon, G.L.O.**

- #1 - 20" Birch S45°E 21 Links
- #2 - 22" Hemlock S47°W 26 Links

**1891-1904 - A.O. Temple Co. Sur.**

- Remonumentation of T17N, R8W
- "Identified by O.B.T. & Stakes".
- Set 3" Clay Tile.
- #3 - 24" Hemlock Stump N53°W 49 Links
- #4 - 22" Hemlock Stump S47°W 26 Links

**1978 - G. Gray, LS 17741**

- Survey recorded L. 360, Pg. 276
- "Set Conc. Mon. over Tile".
- L.C.R.C. - Liber 02, Pg. 115.
- #5 - 14" Poplar S80°W 9.55'
- #6 - 4" Cedar N5°E 9.90'
- #7 - 20" Tw. Maple S40°E 44.00'

**B. Description of corner evidence found and/or method applied in restoring or reestablishing corner:**

I found Gray's 4" diameter concrete monument over top of a 3" clay tile. I measured the following distances: 2615.30 feet North and 2617.10 feet South to the respective Section corner.

I believe Gray's accessories are incorrect and for some other corner.

Condition of the accessories are as follows: #1 Gone, #2 Gone, #3 Gone, #4 Gone, #5 Gone, #6 Gone, #7 Gone.


**C. Description of monument for corner and accessories established to perpetuate locating the position of the corner:**

I accepted the 4" diameter Concrete Monument as a substantial marker for the corner, and is accepted as a careful and faithful perpetuation of the position of the original corner.

- 11" Cedar N77°W 9.65' (60d spike N. side)
- 12" Cedar N57°E 17.91' (60d spike N. side)
- 6" Cedar N14°W 26.25' (60d spike W. side)
- 8" Cedar S06°E 20.46' (60d spike E. side)

APPROVED LAND CORNER  
P.A. 74 OF 1990  
Osceola County

B. L. W.  
4-20-2000

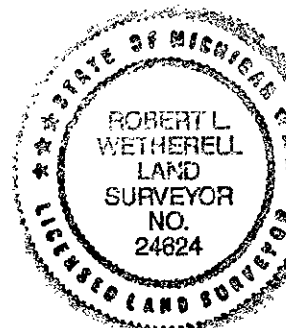

Signed by Robert L. Wetherell  
Surveyor's Michigan License No. 24624

Date April 25, 2000