

SURVEY & REMONUMENTATION

AUG 23 1995

COMMISSION

LAND CORNER RECORDATION CERTIFICATE
Filing Requirement of Act 74, Mich. P.A. 1970

For corners in

Osceola
(County)

Located In:

Corner Code #

17N 8W

E-8

- 1. Public Land Survey T ___ R ___
- T ___ R ___
- T ___ R ___
- T ___ R ___
- 2. Property Controlling S ___ T ___ R ___
- in Section S ___ T ___ R ___
- 3. Miscellaneous S ___ T ___ R ___
- Property in Sec. S ___ T ___ R ___

APPROVED LAND CORNER
P.A. 345 OF 1990
Osceola County

Matthew McClung
August 3, 1995

Register of Deeds Stamp & File Number

- 4. Lot No. _____, Recorded Plat _____
- 5. Private Claims _____

Matthew McClung

July 26, 1995

I, _____, in a field survey on _____, 19____, do hereby certify that under requirements of P.A. 74, Michigan P.A. of 1970, the corner points mentioned in lines 1 and 2 above were in conformance with regulations and rules therefore as required in the current manual of survey instructions of the United States Department of the Interior, Bureau of Land Management or by a decree of a Court of Law and/or that the corner points mentioned in lines 3, 4 and 5 above were in conformance with the rules of the Michigan Board of Land Surveyors or by a Decree of a Court of Law; established, re-established, monumented, re-monumented, recovered, found as expressed below:

NOTE: Not more than 4 corners, all in the same town and range, may be recorded on this certificate.

	A	B	C	D	E	F	G	H	I	J	K	L	M
2	6	5	4	3	2	1							
3													
4	7	8	9	10	11	12							
5													
6	18	17	16	15	14	13							
7													
8	19	20	21	22	23	24							
9													
10	30	29	28	27	26	25							
11													
12	31	32	33	34	35	36							
13													

A. Description of original monument and accessories and/or subsequent restoration:

The original survey was by deputy surveyor Orson Lyon on April 14, 1847. The total mile calls 80.00 chains with the corner falling in Saddle Bag Lake.

I have shown 4 P.A. 132 surveys, by McClung and Wetherell.

I have shown from the County survey records, Township of Evert book, pages 30 and 31. and front pages, page 4 mid page.

B. Description of corner evidence found and/or method applied in restoring or reestablishing corner:


Corner E-8 is in Saddlebag Lake. Found South 1/16 Corner west Line of Section 21. Found stump of Elm tree, 10" NE 50.5' as recorded in CSR page 4 front pages of Evert Township book. Corner is a 1/2" rod 5" below surface. Doubling over this corner and the Southwest Section Corner is the best position for Corner E-8. This method of establishing E-8, is a retracement of a survey recorded in CSR, page 4, front pages of Evert Township book.

C. Description of monument for corner and accessories established to perpetuate locating the position of the corner:

OSCEOLA COUNTY
REGISTER OF DEEDS

95 AUG -9 PM 12: 12

Nancy Crawford

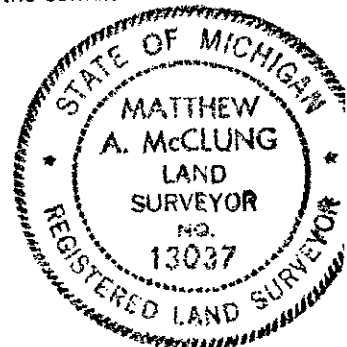

Signed by *Matthew McClung*
Surveyor's Michigan License No. 13037

Date July 26, 1993

FORM APPROVED BY MICHIGAN STATE BOARD OF LAND SURVEYORS, JAN. 28, 1971
REVISED MAY 14, 1975
REVISED JAN., 1983