


**SURVEY & REMONUMENTATION**

DEC 13 2000

**SECTION LAND CORNER RECORDATION CERTIFICATE**  
 FILING REQUIREMENT OF ACT 74, Mich. P.A. 1970

For corners in <u>Osceola</u>	Located in:	Corner Code#
1. Public Land Survey	T <u>17N</u> R <u>8W</u> E-11	
	T _____ R _____	
	T _____ R _____	
	T _____ R _____	
2. Property Controlling in Section	S T _____ R _____	
	S T _____ R _____	
3. Miscellaneous Property in Sec.	S T _____ R _____	
	S T _____ R _____	
4. Lot No. _____ Recorded Plat _____		
5. Private Claims _____		

  
**OSCEOLA COUNTY REGISTER OF DEEDS**  
**00 MAY -5 PM 2:50**  
 Register of Deeds Stamp & File Number

	A	B	C	D	E	F	G	H	I	J	K	L	M
1													
2	6	5	4	3	2	1							
3													
4	7	8	9	10	11	12							
5													
6	18	17	16	15	14	13							
7													
8	19	20	21	22	23	24							
9													
10	30	29	28	27	26	25							
11													
12	31	32	33	34	35	36							
13													

I, Robert L. Wetherell, in a field survey on March 22, 2000, do hereby certify that under requirements of P.A. 74, Michigan P.A. of 1970, the corner points mentioned in lines 1 and 2 above were in conformance with regulations and rules therefore as required in the current manual of survey instructions of the United States Department of the Interior, Bureau of Land Management or by decree of a Court of Law and/or that the corner points mentioned in lines 3, 4, and 5 above were in conformance with the rules of the Michigan Board of Land Surveyors or by a Decree Of a Court of Law; established, re-established, monumented, re-monumented, recovered, found as expressed below:

**E-11 - Sec. corner common to Sections 28, 29, 32 & 33, T17N, R8W**

**A. Description of original monument and accessories and/or subsequent restoration:**

- |   |  |  |
|---|--|--|
| <b>1848 - G. Lyon G.L.O.</b><br>#1 - 10" Beech N68°E 37 Links<br>#2 - 18" Beech S21°W 27 Links<br><b>1890 - L. June, Co. Sur.</b><br>Post with stone & crockery.<br>#13 - Measured 2621.5'<br>North to ¼ Cor.<br><b>1891-1904 - A.O. Temple</b><br>Remonumentation of T17N, R8W<br>"Identified by Stake".<br>#3 - 14" Beech N61°E 99½ Links<br>#4 - 36" Pine Stump S30½°W<br>89 ½ Links | <b>1966 - J. Lazarowitz</b><br>Developed plat of<br>"Lake Mirimichi Sub".<br><b>1987 - J. Taylor, LS 32342</b><br>L.C.R.C. - Liber 02, Pg. 276<br>Set ½" rebar at position from<br>information from plat of<br>"Lake Mirimichi".<br>#5 - 1" Iron Rod S65°W 50.52'<br>#6 - 1" Iron Rod S75°E 62.46'<br>#7 - 36" R. Oak N75°E 47.83'<br>#8 - 20" R. Maple S70°W 11.04' | <b>1998 - R.L. Wetherell, LS 24624</b><br>L.C.R.C. - Liber 03, Pg. 186.<br>Found 3" Clay Tile from remains of<br>Trumbull's O.B.T. Pine Stump.<br>#9 - 9" R. Oak S76°E 54.12'<br>#10 - 40" R. Oak N62°E 63.84'<br>#11 - 10" Maple N32°W 46.19'<br>#12 - 14" Maple S52°W 24.44' |
|---|--|--|

**B. Description of corner evidence found and/or method applied in restoring of reestablishing corner:**


I found the ½" rod (I set in 1998) in the center of a 3" clay tile with cinders. I also found Taylor's ½ Capped Iron N31°E 20.40' from the tile. I accepted the tile and removed Taylor's Iron. Corner is in the center more or less of an old road bed running East and West, and 4 feet more or less North of an old East and West fence.

Condition of the accessories are as follows: #1 Gone, #2 Gone, #3 Gone, #4 Found remains of stump, #5 Found in good condition, #6 Found in good condition, #8 Found in good condition, #9 Found in good condition, #10 Found in good condition, #11 Found in good condition, #12 Found in good condition, #13 Measured 2634.11'.

**C. Description of monument for corner and accessories established to perpetuate locating the position of the corner:**  
 I replaced the ½" rod (in tile) with a 1" x 18" Iron Pipe with an Osceola County Remon Cap and is accepted as a careful and faithful perpetuation of the position of the original corner.

- 9" R. Oak S76°E 54.12' (60d spike S. side) #9
- 40" R. Oak N62°E 63.84' (60d spike N. side) #10
- 10" Maple N32°W 46.19' (60d spike W. side) #11
- 14" Maple S52°W 24.44' (60d spike N.W. side) #12

APPROVED LAND CORNER  
 P.A. 2-5 OF 1990  
 Osceola County  
R. L. W.  
4-20-2000

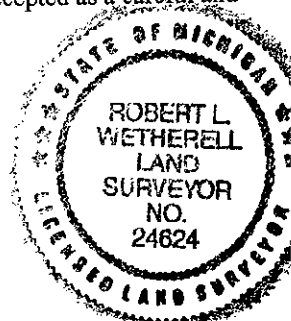

Signed by Robert L. Wetherell  
 Surveyor's Michigan License No. 24624

Date April 25, 2000