

SURVEY & REMONUMENTATION

DEC 13 2000

SECTION LAND CORNER RECORDATION CERTIFICATE
 FILING REQUIREMENT OF ACT 74, Mich. P.A. 1970

For corners in Osceola Located in: Corner Code#

1. Public Land Survey	T 17 N	R 8 W	G-11
	T	R	
	T	R	
	T	R	
2. Property Controlling in Section	S T	R	
	S T	R	
3. Miscellaneous Property in Sec.	S T	R	
	S T	R	
4. Lot No. _____ Recorded Plat _____			
5. Private Claims _____			

OSCEOLA COUNTY
 REGISTER OF DEEDS
 00 MAY -5 PM 2:50
Tracy Campbell

Register of Deeds Stamp & File Number

I, Robert L. Wetherell, in a field survey on March 22, 2000, do hereby certify that under requirements of P.A. 74, Michigan P.A. of 1970, the corner points mentioned in lines 1 and 2 above were in conformance with regulations and rules therefore as required in the current manual of survey instructions of the United States Department of the Interior, Bureau of Land Management or by decree of a Court of Law and/or that the corner points mentioned in lines 3, 4, and 5 above were in conformance with the rules of the Michigan Board of Land Surveyors or by a Decree Of a Court of Law; established, re-established, monumented, re-monumented, recovered, found as expressed below:

	A	B	C	D	E	F	G	H	I	J	K	L	M
1													
2	6	5	4	3	2	1							
3													
4	7	8	9	10	11	12							
5													
6	18	17	16	15	14	13							
7													
8	19	20	21	22	23	24							
9													
10	30	29	28	27	26	25							
11													
12	31	32	33	34	35	36							
13													

G-11 - Section corner common to Sections 27, 28, 33 & 34, T17N, R8W.

A. Description of original monument and accessories and/or subsequent restoration:

1848 - O. Lyon, G.L.O.

#1 - 16" Beech N71°W 8 Links

#2 18" Beech N45°E 25 Links

1891-1904 - A.O. Temple

Remonumented T17N R8W with 3" Clay Tiles.

#3 - 6" F. Post N48½°E 53½ Links

#4 - 6" F. Post N40°W 46 Links

Undated From Co. Sur. Twp. Notes

"Pipe"

#5 - Apple S.E. 102.4'

#6 - Elm S.E. 72'

#3 - Post N50°E 35.3'

#7 - 8" Poplar N43°W 37.1'

1966 - J. Lazarowitz

Developed plat of "Lake Mirimichi" Sub.

No monument or accessories given.

Undated M. McClung, LS 13037

"Set corner by extending plat line of

Mirimichi subdivision to the East

plat distance".

1998 - R.L. Wetherell, LS 24624

L.C.R.C. - Liber 03, Pg. 186.

Found ¼" Capped Iron by McClung.

#5 - 16" Apple S69°E 103.05'

#8 - P. Pole S38°W 127.10'

#9 - S.E. cor. bldg. foundation N48°W 120.6'

B. Description of corner evidence found and/or method applied in restoring of reestablishing corner:

I found McClung's capped iron in the intersection of roads North, South and East. I made an extensive dig for the clay tile but was unsuccessful in recovering it. I accepted McClung's capped iron because it fits the Apple Tree (accessory #5) mentioned in the old township books reasonably well and it also fits 1/16 fences to the North. I measured North 2635.16 feet to the ¼ corner and 2643.88 feet West to the ¼ corner.

Condition of the accessories are as follows: #1 Gone, #2 Gone, #3 Gone, #4 Gone, #5 Found in good condition, #6 Gone, #7 Gone, #8 Found in good condition, #9 Found in good condition.

C. Description of monument for corner and accessories established to perpetuate locating the position of the corner:

I replaced the ¾" iron by McClung with a 1" x 18" iron pipe with Osceola County Remon Cap, and is accepted as a careful and faithful reestablishment of the position of the original corner.

16" Apple S69°E 103.03' (60d spike in N. side) #5


P. Pole S38°W 127.10' (P.K. nail S.E. side) #8

S.E. cor. bldg. foundation N48°W 120.69' (#9)

6" Apple N3°W 156.20' (60d spike in E. side)

APPROVED LAND CORNER
 P.A. 345 OF 1990
 Osceola County

R. L. W.
 4-20-2000

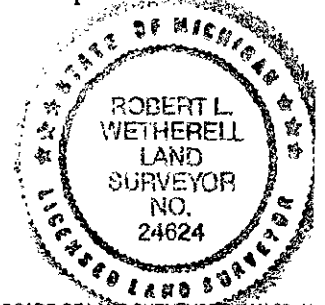

Signed by Robert L. Wetherell
 Surveyor's Michigan License No. 24624

Date April 25, 2000

FORM APPROVED BY MICHIGAN STATE BOARD OF LAND SURVEYORS, JAN. 28, 11
 REVISED MAY 14, 1
 REVISED JAN., 1
 ADAPTED FOR WORD PROCESSING JANUARY, 1