

**SURVEY & REMONUMENTATION**

DEC 13 2000

SECTION

**LAND CORNER RECORDATION CERTIFICATE**

FILING REQUIREMENT OF ACT 74, Mich. P.A. 1970

For corners in  
Osceola

|                                    | Located in:  | Corner Code# |
|------------------------------------|--------------|--------------|
| 1. Public Land Survey              | T 17 N R 8 W | G-13         |
|                                    | T R          |              |
|                                    | T R          |              |
|                                    | T R          |              |
| 2. Property Controlling in Section | S T R        |              |
|                                    | S T R        |              |
| 3. Miscellaneous Property in Sec.  | S T R        |              |
|                                    | S T R        |              |
| 4. Lot No. Recorded Plat           |              |              |
| 5. Private Claims                  |              |              |

OSCEOLA COUNTY  
 REGISTER OF DEEDS  
 00MAY -5 PM 2:50  
*Thomas Crawford*

Register of Deeds Stamp & File Number

|    | A  | B  | C  | D  | E  | F  | G | H | I | J | K | L | M |
|----|----|----|----|----|----|----|---|---|---|---|---|---|---|
| 1  |    |    |    |    |    |    |   |   |   |   |   |   |   |
| 2  | 6  | 5  | 4  | 3  | 2  | 1  |   |   |   |   |   |   |   |
| 3  |    |    |    |    |    |    |   |   |   |   |   |   |   |
| 4  | 7  | 8  | 9  | 10 | 11 | 12 |   |   |   |   |   |   |   |
| 5  |    |    |    |    |    |    |   |   |   |   |   |   |   |
| 6  | 18 | 17 | 16 | 15 | 14 | 13 |   |   |   |   |   |   |   |
| 7  |    |    |    |    |    |    |   |   |   |   |   |   |   |
| 8  | 19 | 20 | 21 | 22 | 23 | 24 |   |   |   |   |   |   |   |
| 9  |    |    |    |    |    |    |   |   |   |   |   |   |   |
| 10 | 30 | 29 | 28 | 27 | 26 | 25 |   |   |   |   |   |   |   |
| 11 |    |    |    |    |    |    |   |   |   |   |   |   |   |
| 12 | 31 | 32 | 33 | 34 | 35 | 36 |   |   |   |   |   |   |   |
| 13 |    |    |    |    |    |    |   |   |   |   |   |   |   |


I, Robert L. Wetherell, in a field survey on March 22, 2000, do hereby certify that under requirements of P.A. 74, Michigan P.A. of 1970, the corner points mentioned in lines 1 and 2 above were in conformance with regulations and rules therefore as required in the current manual of survey instructions of the United States Department of the Interior, Bureau of Land Management or by decree of a Court of Law and/or that the corner points mentioned in lines 3, 4, and 5 above were in conformance with the rules of the Michigan Board of Land Surveyors or by a Decree Of a Court of Law; established, re-established, monumented, re-monumented, recovered, found as expressed below:

**G-13- Sec. Corner common to Sec. 33 & 34, T17N, R8W - On County Line.**

- A. Description of original monument and accessories and/or subsequent restoration:**
- |  |  |   |
|--|--|---|
| <p><u>1848 - O. Lyon, G.L.O.</u><br/>                 #1 - 8" Beech N20°E 20 Links<br/>                 #2 - 18" Hemlock N18°W 65 Links<br/> <u>1891-1904 - A.O. Temple</u><br/>                 "Identified by Tile &amp; O.B.T'S".<br/>                 Set 3" Clay Tile.<br/>                 #3 - 36" Pine Stump N33½°E 92 Links<br/>                 #4 - 30" Pine Stump N79¼°E 25½ Links<br/> <u>1906 - F. Trumbull, Co. Sur.</u><br/>                 From Mecosta Co. Sur. Records<br/>                 in Sec. 3, T16N, R8W<br/>                 #5 - Measured East to Sec. Cor. 2621.52'</p> | <p><u>Undated Co. Sur. Twp. Book</u><br/>                 #3 - 36" Pine Stump N33½°E 92 Links<br/>                 #4 - 30" Pine Stump N79¼°E 25½ Links<br/> <u>1925 - E.E. Sours</u><br/>                 From Mecosta Co. Sur. Records<br/>                 #6 - 12" Elm S78°45'E 72.5'<br/>                 #7 - 6" Maple N41°W 43.6'<br/> <u>1966 - J. Lazarowitz</u><br/>                 Developed plat of "Lake Mirimichi".<br/>                 Set Concrete Monument.</p> | <p><u>1972 - M. McClung, LS 13037</u><br/>                 L.C.R.C. - Liber 01, Pg. 148<br/>                 Survey rec. Liber 302, Pg. 62.<br/>                 Found concrete monument.<br/>                 Set Osceola Co. monument.<br/>                 #8 - Plat Monument 33' - West.<br/> <u>1996 - R.L. Wetherell, LS 24624</u><br/>                 Found Tile &amp; Iron.<br/>                 #9 - 14" W. Pine N34°W 38.50'<br/>                 #10 - 7" Elm S80°W 35.52'<br/>                 #11 - 18" Basswood N59°E 76.41'<br/>                 #12 - 13" Tw. Maple N82°E 91.93'</p> |
|--|--|---|
- B. Description of corner evidence found and/or method applied in restoring of reestablishing corner:**  
 I found a ½" iron in center of 3" clay tile 6 feet more or less west of centerline of North and South road and in line more or less with old fence (down) running West. I also found a 1" pipe with an Osceola County Remon Cap, which was directly over a 4" diameter Concrete Monument. This 1" pipe was S54°E 12.65 feet from the clay tile. I accepted the clay tile as the correct corner. I removed the 1" pipe with Osceola County Remon Cap but left the 4" Concrete Monument.
- Condition of the accessories are as follows: #1 Gone, #2 Gone, #3 Gone, #4 Gone, #5 Measured 2653.76', #6 Gone, #7 Gone, #8 Gone, #9 Found in good condition, #10, Found in good condition, #11 Found in good condition (Ash), #12 Found in good condition.
- C. Description of monument for corner and accessories established to perpetuate locating the position of the corner:**  
 I placed as 1" x 18" Iron Pipe with an Osceola County Remon Cap in the center of the 3" Clay Tile and is accepted as a careful and faithful perpetuation of the position of the original corner.

- 15" W. Pine N34°W 38.50' (60d spike in N.E. side) #9
- 7" Elm S80°W 32.52' (60d spike in N. side) #10
- 18" Ash N59°E 76.41' (60d spike in N.W. side) #11
- 13" Tw. Maple N82°E 91.93" (60d spike in S. side) #12

APPROVED LAND CORNER  
 P.A. 74 OF 1970  
 Osceola County  
*R.L.W.*  
 4-20-2000

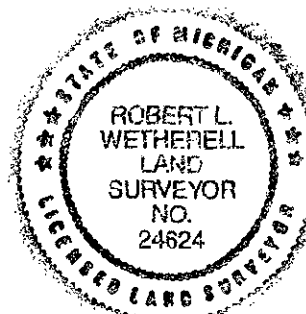

Signed by Robert L. Wetherell  
 Surveyor's Michigan License No. 24624

Date April 25, 2000