

**SURVEY &  
REMONUMENTATION**

OCT 29 1996

**LAND CORNER RECORDATION CERTIFICATE  
Filing Requirement of Act 74, Mich. P.A. 1970**

For corners in **COMMISSION**

<u>Osceola</u> (County)	Located In:	Corner Code #
1. Public Land Survey	T <u>17N</u> R <u>3W</u>	<u>H-7</u>
	T <u>    </u> R <u>    </u>	<u>    </u>
	T <u>    </u> R <u>    </u>	<u>    </u>
	T <u>    </u> R <u>    </u>	<u>    </u>
2. Property Controlling in Section	S <u>    </u> T <u>    </u> R <u>    </u>	<u>    </u>
	S <u>    </u> T <u>    </u> R <u>    </u>	<u>    </u>
3. Miscellaneous	S <u>    </u> T <u>    </u> R <u>    </u>	<u>    </u>
Property in Sec.	S <u>    </u> T <u>    </u> R <u>    </u>	<u>    </u>

APPROVED LAND CORNER  
P.A. 345 OF 1990  
Osceola County

*Matthew McClung*  
26 Sept 1996

Register of Deeds Stamp & File Number

4. Lot No. \_\_\_\_\_, Recorded Plat \_\_\_\_\_  
5. Private Claims \_\_\_\_\_

Matthew McClung, in a field survey on 8-13, 1996 do hereby state that under requirements of P.A. 74, Michigan P.A. of 1970, the corner points mentioned in lines 1 and 2 above were in conformance with regulations and rules therefore as required in the current manual of survey instructions of the United States Department of the Interior, Bureau of Land Management or by a decree of a Court of Law and/or that the corner points mentioned in lines 3, 4 and 5 above were in conformance with the rules of the Michigan Board of Land Surveyors or by a Decree of a Court of Law; established, re-established, monumented, recovered, found as expressed below:


NOTE: Not more than 2 corners, all in the same town and range, may be recorded on this certificate.

1	A	B	C	D	E	F	G	H	I	J	K	L	M
2		6		5		4		3		2		1	
3													
4		7		8		9		10		11		12	
5													
6		19		17		16		15		14		13	
7													
8		19		20		21		22		23		24	
9													
10		30		29		28		27		26		25	
11													
12		31		32		33		34		35		36	
13													

A. Description of original monument and accessories and/or subsequent restoration:  
The original corner was set by deputy surveyor Orson Lyons on 14 November 1847. Set wood post 40.30 chains from East.  
Beech 18" N85E 57 lks.  
Beech 14" S25E 36 lks.

From 1891 to 1904 approximately, Osceola County had a remonumentation program, in which surveyors Temple and Trumbull, did the work. For the most part, a 3" glazed tile filled with cinders from a forge, were placed at each government set corner in the township. There were supposed to be 3 tile per corner, placed atop of each other, (continued on back)

B. Description of corner evidence found and/or method applied in restoring or reestablishing corner:  
Set Osceola County Monument in Centerline of East and West Road 3" below surface. Corner is in fence row going South. Distance from East is 2669.07 feet and going West is 2664.535 feet.

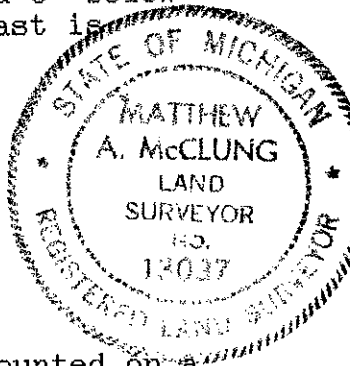

C. Description of monument for corner and accessories established to perpetuate locating the position of the corner:  
Corner H-7. Osceola County Monument, which is a 3" brass cap mounted on a 1" pipe 18" in length.  
Power Pole N16W 43.10 feet.  
East most Guy Wire N38W 42.10 feet.  
Power Pole S08W 42.30 feet.  
Telephone Pedestal N70W 83.85 feet.

Signed by *Matthew McClung* Date August 7, 1996  
Surveyor's Michigan License No. 13037

OSCEOLA COUNTY  
REGISTER OF DEEDS

96 OCT 10 PM 4: 38

*Nancy Crawford*

thereby making the corner 4 feet long. Sometimes a solid tile, with a cross in the top was used, and sometimes a 1/2" iron bars were added to the tile. Notes of the work were kept in ledgers, and given to the townships, and 5 of the townships have been recorded in the County records.

Ewart Township Survey records book; Front pages, page 3 and pages 30 and 31.

SURVEY &  
REMONUMENTATION

OCT 29 1996

COMMISSION