

**SURVEY &
REMONUMENTATION**

DEC 1 6 1996

COMMISSION

LAND CORNER RECORDATION CERTIFICATE
Filing Requirement of Act 74, Mich. P.A. 1970

For corners in

Osceola	Located in:	Corner Code #
(County)		
1. Public Land Survey	T <u>7N</u> R <u>8W</u>	<u>M-7</u>
	T _____ R _____	_____
	T _____ R _____	_____
	T _____ R _____	_____
2. Property Controlling in Section	S _____ T _____ R _____	_____
	S _____ T _____ R _____	_____
3. Miscellaneous Property in Sec.	S _____ T _____ R _____	_____
	S _____ T _____ R _____	_____

APPROVED LAND CORNER
P.A. 345 OF 1990
Osceola County
Matthew McClung
7 Nov. 1996
Register of Deeds Stamp & File Number

4. Lot No. _____, Recorded Plat _____
5. Private Claims _____

I, Matthew McClung, in a field survey on 07-20, 1996 do hereby state that under requirements of P.A. 74, Michigan P.A. of 1970, the corner points mentioned in lines 1 and 2 above were in conformance with regulations and rules therefore as required in the current manual of survey instructions of the United States Department of the Interior, Bureau of Land Management or by a decree of a Court of Law and /or that the corner points mentioned in lines 3, 4 and 5 above were in conformance with the rules of the Michigan Board of Land Surveyors or by a Decree of a Court of Law; established, re-established, monumented, recovered, found as expressed below:

NOTE: Not more than 2 corners, all in the same town and range, may be recorded on this certificate.

1	A	B	C	D	E	F	G	H	I	J	K	L	M
2		6		5		4		3		2		1	
3													
4		7		8		9		10		11		12	
5													
6		18		17		16		15		14		13	
7													
8		19		20		21		22		23		24	
9													
10		30		29		28		27		26		25	
11													
12		31		32		33		34		35		36	
13													

A. Description of original monument and accessories and/or subsequent restoration:

The original corner was set by deputy surveyor Orson Lyons on 28 October 1837 Set wood post at 80.00 chains from South.
16" Pine For Corner.

From 1891 to 1904 approximately, Osceola County had a remonumentation program, in which surveyors Temple and Trumbull, did the work. For the most part, a 3" glazed tile filled with cinders from a forge, were placed at each government set corner in the township. There were supposed to be 3 tile per corner, placed atop of each other, (continued on back)

B. Description of corner evidence found and/or method applied in restoring or reestablishing corner:

Found 1" x 1" x 6 1/2" bolt, 3 feet South of centerline of East and West road and in centerline of North road 1" below surface. Excavated to 20" and found 1" pipe and tile. Placed Osceola County Monument over pipe 3" below surface.


C. Description of monument for corner and accessories established to perpetuate locating the position of the corner:

Corner M-7. Osceola County Monument, which is a 3" brass cap mounted on a 1" pipe 18" in length.

- Power Pole N58W 61.15 feet.
- 34" W> Oak N30E 59.45 feet.
- Cement Project Marker N62E 75.55 feet.
- West Gate Post S74E 91.30 feet.

Signed by *Matthew McClung*
Surveyor's Michigan License No. 13037

Date September 20, 1996

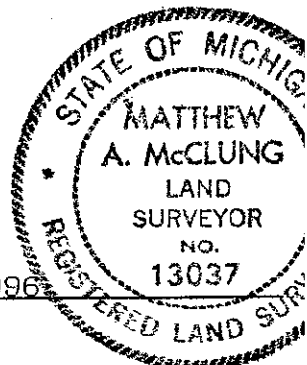

OSCEOLA COUNTY
REGISTER OF DEEDS

96 NOV 26 PM 2:15

Harvey Crawford

thereby making the corner 4 feet long. Sometimes a solid tile, with a cross in the top was used, and sometimes a 1/2" iron bars were added to the tile. Notes of the work were kept in ledgers, and given to the townships, and 5 of the townships have been recorded in the County records.

I have shown 2 L.C.R.C; Liber 1, Page 430; Liber 2, Page 14.

I have shown 1 PA 132; Liber 592, Pages 408-410.

SURVEY &
REMONUMENTATION

DEC 1 6 1995

COMMISSION