

LAND CORNER RECORDATION CERTIFICATE

FILING REQUIREMENT OF ACT 74, MICH. P.A.1970

| FOR CORNERS OF--: | LOCATED IN--: | CORNER CODE NUMBER |
|--|---|--------------------|
| 1. PUBLIC LAND SURVEY _____ | T. 17 <input checked="" type="radio"/> N. <input type="radio"/> S., R. 9 <input checked="" type="radio"/> W. <input type="radio"/> E. | H-1; I-1; K-1 |
| 2. PROPERTY CONTROLLING IN SECTION 3 _____ | T. 17 <input checked="" type="radio"/> N. <input type="radio"/> S., R. 9 <input checked="" type="radio"/> W. <input type="radio"/> E. | 2 |
| 3. MISCELLANEOUS PROPERTY IN SECTION _____ | T. _____, R. _____, S. _____, E. _____ | |
| 4. LOT NO. _____, RECORDED PLAT _____ | | |
| 5. PRIVATE CLAIMS _____ | | |

REGISTER OF DEEDS STAMP AND FILING NUMBER

I, Kenneth J. Ostling, do hereby certify that under requirements of P.A. 74, Michigan P.A. of 1970, the corner points mentioned in lines 1 and 2 above were, in a field survey on July 25, 1977, established, re-established, monumented, re-monumented, recovered or restored as expressed below and in conformance with regulations and rules therefore as required in the current manual of survey instructions of the United States Department of the Interior, Bureau of Land Management or by a decree of a court of law. Furthermore, that the corner points mentioned in lines 3, 4 and 5 above were, in a field survey on _____, 19____, found, recovered, restored, established or re-established as expressed below and in conformance with the rules of the Michigan State Board of Registration for Land Surveyors or, by a Decree of a Court of law:

~~A = description of original monument and accessories and/or subsequent restoration~~
 C. (continued)


- 2
- Set DNR mon. & cedar post
 - 10" Maple in clump of 3 S80°E 37.4
 - 17" W. Oak S20°W 48.4
 - E-W random Due N 9.6
 - E 1/16 on S line 34 T18N-R9W
 - Due W 31.9

- B. Description of corner evidence found and/or method applied in restoring or re-establishing corner:
- H-1 Set corner by proportionate measurement, midpoint on line, between section corners of Sec. 3.
 - I-1 Set corner U.S. record measure easterly of standard corner. No evidence of a previous closing corner.
 - K-1 Set corner at U.S. record measurement easterly of the recovered standard section corner. Nothing in place for a previous corner.
 - 2 Set by standard survey procedure for subdivision of sections.

C. Description of monument for corner and accessories established to perpetuate locating the position of the corner:

| H-1 | I-1 | K-1 |
|---------------------------|---------------------------|---------------------------|
| Set DNR mon. & cedar post | Set DNR mon. & cedar post | Set DNR mon. & cedar post |
| 9" W. Oak N45°E 43.9 | 10" Maple S50°E 23.7 | 2" Maple S60°E 19.7 |
| 13" Maple S25°W 48.6 | 4" Maple S45°W 33.0 | 6" Maple S20°W 28.7 |
| E-W random Due N 1.9 | E-W random Due N 17 | SE Sec. 35 T18N-R9W |
| S 1/4 Sec. 34 T18N-R9W | SE Sec. 34 T18N-R9W | Due W 24.4 |
| Due W 19.6 | Due W 44.4 | |

SIGNED BY *Kenneth J. Ostling* DATE 12-77
 SURVEYOR'S MICHIGAN REGISTRATION NO. 10068

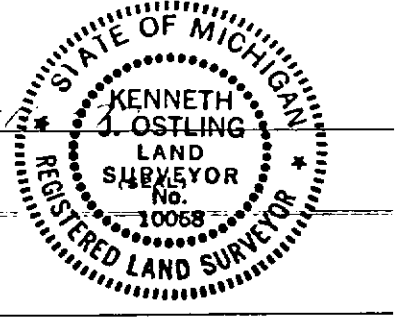

FOR STATE AND UNITED STATES AGENCIES:
 SIGNED BY _____ DATE _____
CHIEF OF SURVEY PARTY
 APPROVED AND SIGNED BY _____ DATE _____
MICHIGAN REGISTERED LAND SURVEYOR (SEAL)

SURVEYOR'S MICHIGAN REGISTRATION NO. _____ HERSEY TOWNSHIP
 OSCEOLA COUNTY

MAY PLACE SKETCH ON BACK OR ATTACHED SHEET