

LAND CORNER RECORDATION CERTIFICATE
Filing Requirement of Act 74, Mich. P.A. 1970

For corners in

<u>Osceola</u> <small>(County)</small>	Located In:	Corner Code #
1. Public Land Survey	T <u>17N</u> R <u>9W</u>	<u>L-2</u>
	T _____ R _____	_____
2. Property Controlling in Section	S _____ T _____ R _____	_____
	S <u>1</u> T <u>17N</u> R <u>9W</u>	<u>12</u>
3. Miscellaneous Property in Sec.	S _____ T _____ R _____	_____
	S _____ T _____ R _____	_____

Register of Deeds Stamp & File Num

4. Lot No. _____, Recorded Plat _____

5. Private Claims _____

I, Craig W. McVean, in a field survey on Jan. 22, 19 98 do hereby state that under requirements of P.A. 74, Michigan P.A. of 1970, the corner points mentioned in lines 1 and 2 above were in conformance with regulations and rules therefore as required in the current manual of survey instructions of the United States Department of the Interior, Bureau of Land Management or by a decree of a Court of Law and /or that the corner points mentioned in lines 3, 4 and 5 above were in conformance with the rules of the Michigan Board of Land Surveyors or by a Decree of a Court of Law; established, re-established, monumented, recovered, found as expressed below:


	A	B	C	D	E	F	G	H	I	J	K	L	M
1													
2		6		5		4		3		2		●	
3												●	
4		7		8		9		10		11		12	
5													
6		18		17		16		15		14		13	
7													
8		19		20		21		22		23		24	
9													
10		30		29		28		27		26		25	
11													
12		31		32		33		34		35		36	
13													

NOTE: Not more than 2 corners, all in the same town and range, may be recorded on this certificate.

A. Description of original monument and accessories and/or subsequent restoration:

L-2 - Lakestate Sur. & Eng. - File 2379-75
 C. Cole - 1975 - Set Iron L. 325, P. 604,
 Osceola County records.

12 - Lakestate Sur. & Eng. - File 2379-75
 C. Cole - 1975 - Set Iron L. 325, P. 604,
 Osceola County records.

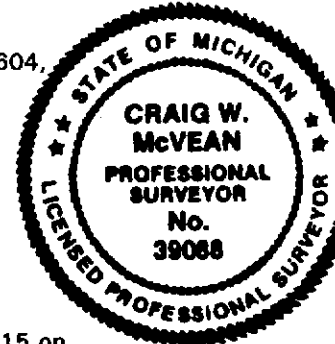

B. Description of corner evidence found and/or method applied in restoring or reestablishing corner:

L-2 - C 1/4 Corner - Fnd. PS Cap #17615 on
 1/2" x 18" rebar per Lakestate Sur. - Fits
 Calculated 1/4 line intersection closely
 Monument accepted as the best
 available evidence of the position
 of the corner.

12 - C-S 1/16 Corner - Fnd. PS Cap #17615 on
 1/2" x 18" rebar per Lakestate Sur.
 Fnd iron fits BLM procedure position and
 accepted as the best available evidence of
 the corner.
 Fnd 2" pipe 0.5' above surface on W. side
 bar and cap.

C. Description of monument for corner and accessories established to perpetuate locating the position of the corner:

L-2 - Replaced capped 1/2" rebar with
 2" Alum. Cap on 5/8" x 34" rebar on W.
 side fnd. cedar post.
 N53°E 40.78' Set N&T SW Side 4" B. Oak
 N25°E 64.16' Set N&T NW Side 3" W. Oak
 N70°E 47.98' Set N&T S. Side 8" W. Oak
 S80°W 128.35' Set N&T S. Side 10" W. Pine
 Set Blue Carsonite post 1' NW

12 - Replaced capped 1/2" rebar with
 2" Alum. Cap on 5/8" x 34" rebar
 S23°W 23.02' Set N&T E. Side 3" R. Maple
 N69°W 24.46' Set N&T N. Side 3" R. Maple
 N27°W 28.14' Set N&T W. Side 3" B. Cherry
 N87°E 35.84' Set N&T N. Side 19" Tri. R. Maple
 Set Blue Carsonite post 1' NW
 Reset 2" x 2' Pipe 0.3' SE - up 1'

Signed by Craig W. McVean
 Surveyor's Michigan License No. 39088

Date 4/20/1998