

LAND CORNER RECORDATION CERTIFICATE
Filing Requirement of Act 74, Mich. P.A. 1970

For corners in


<u>Osceola</u> <small>(County)</small>	Located In:	Corner Code #
1. Public Land Survey	T 17N R 9W	G-2
2. Property Controlling in Section	S _____ T _____ R _____	_____
3. Miscellaneous Property in Sec.	S _____ T _____ R _____	_____

Register of Deeds Stamp & File No.

4. Lot No. _____, Recorded Plat _____

5. Private Claims _____

I, Craig W. McVean, in a field survey on April 2, 19 98 do hereby state that under requirements of P.A. 74, Michigan P.A. of 1970, the corner points mentioned in lines 1 and 2 above were in conformance with regulations and rules therefore as required in the current manual of survey instructions of the United States Department of the Interior, Bureau of Land Management or by a decree of a Court of Law and /or that the corner points mentioned in lines 3, 4 and 5 above were in conformance with the rules of the Michigan Board of Land Surveyors or by a Decree of a Court of Law; established, re-established, monumented, recovered, found as expressed below:

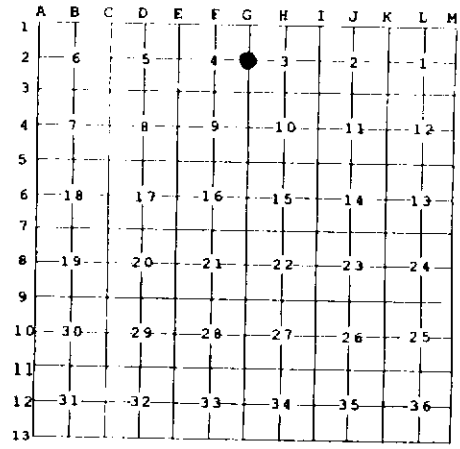

NOTE: Not more than 2 corners, all in the same town and range, may be recorded on this certificate.

A. Description of original monument and accessories and/or subsequent restoration:

- | | |
|---|--|
| <p>G-2 - GLO - Set post - J. Hodgson - 1838
 Birch 12" N55°W 16 L.
 Hemlock 7" S56°W 14 L.</p> | <p>- LCRC - L.1, P. 373 - C. Cole - 1975
 FND. 5/8" Rod. Raised w/axle
 shaft in Ctr. E-W gravel road.
 4" Gate post S70°W 72.86'
 18" Maple N41°W 48.88'
 8" Maple S39°E 42.30'</p> |
| <p>- Osceola CO. Remon - 1900 ± Temple and/or
 Trumbull-set Iron & Tile Mon at GLO corners.</p> | |
| <p>- Rec. Survey L. 318, P. 241 - C. Cole - 1974</p> | |

B. Description of corner evidence found and/or method applied in restoring or reestablishing corner:

G-2 - 1/4 Corner common to Sec. 3 & 4, T17N, R9W. FND. 1 1/4" x 2.25' long axle shaft. Dig down 3' and find tile Mon. with cinders. Replace shaft with 4" DNR A.C. in 1' of 4" PVC with conc. on 1' x 3' long iron pipe with ring of stone down 1'. Monument fall in CL of E-W gravel road - fences N&S. Monument accepted as the best available evidence of the position of the original corner.

C. Description of monument for corner and accessories established to perpetuate locating the position of the corner:

G-2 - DNR Mon. in tile.
 N11°W 68.44' to set N&T in W. Side 34" R. Maple.
 S69°W 72.82' to centerline top of 4" steel brace post (CC).
 *S38°E 41.86' to set N&T in NE Side 12" R. Maple (CC).
 S41°E 57.09' to set N&T in SW Side 8" W. Pine.
 N37°E 46.83' to set N&T in NW Side 6" R. Pine.

* Old nail above.



Signed by Craig W. McVean
 Surveyor's Michigan License No. 39088

Date 4/20/1998