

SURVEY & REMONUMENTATION

DEC 13 2000

LAND CORNER RECORDATION CERTIFICATE

FILING REQUIREMENT OF ACT 74, Mich. P.A. 1970

SECTION

For corners in <u>Osceola</u>	Located in:	Corner Code#
1. Public Land Survey	T 17 N	R 9 W D-11
	T	R
	T	R
	T	R
2. Property Controlling S in Section	T	R
S	T	R
3. Miscellaneous S Property in Sec.	T	R
S	T	R
4. Lot No. _____ Recorded Plat _____		
5. Private Claims _____		

OSCEOLA COUNTY
REGISTER OF DEEDS
00 OCT 11 AM 9:48
R. L. Wetherell
Register of Deeds Stamp & File Number

	A	B	C	D	E	F	G	H	I	J	K	L	M
1													
2	6	5	4	3	2	1							
3													
4	7	8	9	10	11	12							
5													
6	18	17	16	15	14	13							
7													
8	19	20	21	22	23	24							
9													
10	30	29	28	27	26	25							
11													
12	31	32	33	34	35	36							
13													

I, Robert L. Wetherell, in a field survey on July 19, 2000, do hereby certify that under requirements of P.A. 74, Michigan P.A. of 1970, the corner points mentioned in lines 1 and 2 above were in conformance with regulations and rules therefore as required in the current manual of survey instructions of the United States Department of the Interior, Bureau of Land Management or by decree of a Court of Law and/or that the corner points mentioned in lines 3, 4, and 5 above were in conformance with the rules of the Michigan Board of Land Surveyors or by a Decree Of a Court of Law; established, re-established, monumented, re-monumented, recovered, found as expressed below:

D-11 - 1/4 Corner common to Sections 29 & 32, T17N, R9W

- A. Description of original monument and accessories and/or subsequent restoration:**
- | | | |
|--|--|---|
| 1838 - J. Hodgson, G.L.O.
#1 - 8" Aspen S28°E 19 Links
#2 - 8" Aspen N26°E 25 Links | 1983 - J. Wilcox, LS 14102
Found 5/8" Rod
L.C.R.C. - Liber 02, Pg. 224.
#6 - Fence Post S36°E 44.91' | 1988 - R.L. Wetherell, LS 24624
Survey recorded L. 484, Pg. 371.
Same accessories as Taylor from 1987. |
| 1891 - 1904 - Temple/Trumbull/June
Remonumented T17N, R9W
With 3" Clay Tiles. | #3 - T. Post S50°W 46.75'
#7 - 8" S. Pine N32°W 81.45'
#4 - P. Pole N47°E 49.70' | 1993-1999 - R.L. Wetherell, LS 24624
Survey recorded Liber 569, Pg. 842.
Survey recorded Liber 666, Pg. 760.
Same accessories as above. |
| 1974 - E. Benkert, LS 1237
Survey recorded L. 312, Pg. 518.
Found rod and 3" tile.
#3 - T. Pole S.W. 46.7'
#4 - P. Pole N.E. 50.25'
#5 - Yield Sign N.W. 49.5' | 1987 - J. Taylor, LS 32342
L.C.R.C. - Liber 2, Pg. 278.
Found 5/8" rod, added cap iron.
#4 - U. Pole N45°E 50.11'
#7 - 12" S. Pine N45°W 81.68'
#8 - T. Box S20°E 92.53'
#9 - T. Box S45°W 45.74' | |


B. Description of corner evidence found and/or method applied in restoring of reestablishing corner:
I found a 1/2" Capped Iron (LS 32342) along side a 5/8" rod which was directly above a 3" clay tile. Corner is in the centerline of roads North, South, East and West.

Condition of the accessories are as follows: #1 Gone, #2 Gone, #3 Found pole cut off, #4 Found in good condition, #5 Gone, #6 Found in good condition, #7 Gone, #8 Found in good condition #9 Found in good condition.

C. Description of monument for corner and accessories established to perpetuate locating the position of the corner:
I replaced the 5/8" rod with a 1" x 18" iron pipe with Osceola County Remon Cap, and is accepted as a careful and faithful reestablishment of the position of the original corner.

13" R. Pine S74°W 98.59' (60d spike N. side)
15" Elm S64°W 81.19' (60d spike S.E. side)
P. Pole N48°E 48.22 (Nail and Washer N. side) #4
P. Pole N75°W 199.04' (P.K. Nail in N. side)

APPROVED LAND CORNER
P.A. 345 OF 1990
Osceola County
R. L. W.
8-17-2000

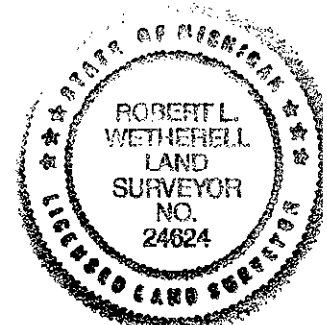

Signed by Robert L. Wetherell
Surveyor's Michigan License No. 24624

Date August 22, 2000

FORM APPROVED BY MICHIGAN STATE BOARD OF LAND SURVEYORS, JAN. 20, 1971
REVISED MAY 14, 1975
REVISED JAN. 1983
ADAPTED FOR WORD PROCESSING JANUARY, 1999