

FEB 16 1999

SECTION

LAND CORNER RECORDATION CERTIFICATE  
Filing Requirement of Act 74, Mich. P.A. 1970

For corners in

Osceola (County)	Located in:	Corner Code #
1. Public Land Survey	T <u>17N</u> R <u>R9W</u>	<u>E-2</u>
	T <u>    </u> R <u>    </u>	<u>    </u>
	T <u>    </u> R <u>    </u>	<u>    </u>
	T <u>    </u> R <u>    </u>	<u>    </u>
2. Property Controlling in Section	S <u>    </u> T <u>    </u> R <u>    </u>	<u>    </u>
	S <u>    </u> T <u>    </u> R <u>    </u>	<u>    </u>
3. Miscellaneous Property in Sec.	S <u>    </u> T <u>    </u> R <u>    </u>	<u>    </u>
	S <u>    </u> T <u>    </u> R <u>    </u>	<u>    </u>

APPROVED LAND CORNER  
P.A. 345 OF 1990  
Osceola County

*Matthew McClung*  
12 Nov. 1998

Register of Deeds Stamp & File Number

4. Lot No. \_\_\_\_\_, Recorded Plat \_\_\_\_\_  
5. Private Claims \_\_\_\_\_

A	B	C	D	E	F	G	H	I	J	K	L	M
1												
2	6		5		4		3		2		1	
3												
4	7		8		9		10		11		12	
5												
6	18		17		16		15		14		13	
7												
8	19		20		21		22		23		24	
9												
10	30		29		28		27		26		25	
11												
12	31		32		33		34		35		36	
13												

I, Matthew McClung, in a field survey on 11-2, 1998 do hereby state that under requirements of P.A. 74, Michigan P.A. of 1970, the corner points mentioned in lines 1 and 2 above were in conformance with regulations and rules therefore as required in the current manual of survey instructions of the United States Department of the Interior, Bureau of Land Management or by a decree of a Court of Law and/or that the corner points mentioned in lines 3, 4 and 5 above were in conformance with the rules of the Michigan Board of Land Surveyors or by a Decree of a Court of Law; established, re-established, monumented, recovered, found as expressed below:

NOTE: Not more than 2 corners, all in the same town and range, may be recorded on this certificate.


A. Description of original monument and accessories and/or subsequent restoration:  
The original corner was set by deputy surveyor John Hodgson 10 June 1838.  
Set wood post 40.00 chains from South.

Beech 7" S55E 15 lks.  
Beech 14" N54E 32 lks.

From 1891 to 1904 approximately, Osceola County had a remonumentation program, in which surveyors Temple and Trumbull, did the work. For the most part, a 3" glazed tile filled with cinders from a forge, were placed at each government set corner in the township. There were supposed to be 3 tile per corner, placed atop of each other, (continued on back)

B. Description of corner evidence found and/or method applied in restoring or reestablishing corner.

Found 1/2" square rod as called for by Cole LCRC for Corner E-2. Hired backhoe, excavated to 30" and found 3" clay tile and 1' X 4" X 3" stone. Placed Osceola County Monument in position over tile, 6" below surface. Corner is 1 or 2' West of centerline of N & S road, in tree lines East and West and in fence row East. Angle right, B.S. NE Cor. Sec. 5, 269d 52' 43"-1.89 feet, to found Cole corner.

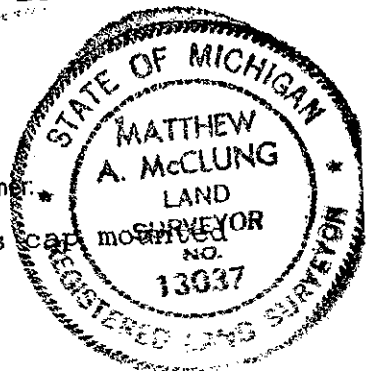

C. Description of monument for corner and accessories established to perpetuate locating the position of the corner.

Corner E-2, is a Osceola County Monument, which is a 3" brass cap mounted on a 1" pipe 18" in length.

- 36" Maple N74W 58.55 feet.
- 8" Maple N82E 61.95 feet.
- 8" Spruce N22W 122.23 feet.
- 6" W. Pine N32E 63.0 feet.
- Elm Stump NW 36.8 feet. O.B.T.

Signed by Matthew McClung 13037  
Surveyor's Michigan License No. \_\_\_\_\_

Date 1 Dec 1998

SWEET &  
RECORDS DIVISION

DEC 1 1998

SECTION

OSCEOLA COUNTY  
REGISTER OF DEEDS

98 DEC -1 PM 4:58

*Nancy Crawford*

thereby making the corner 4 feet long. Sometimes a solid tile, with a cross in the top was used, and sometimes a 1/2" iron bars were added to the tile. Notes of the work were kept in ledgers, and given to the townships, and 5 of the townships have been recorded in the County records.

Hersey Twp. Book, Front pages 4.  
1/4 4 & 5.

Maple SE 44.2'

Bass East 24'

Act. 74, Liber 1, page 373 by Cole.

Set 1/2" sq. iron bar in line with  
fence E & W and gravel road N & S.

E-2- 1/2" iron bar.

8" Ash S85E 23.52'

6" Poplar S51W 39.14'

6" Poplar S80W 43.49'