

**SURVEY &
REMONUMENTATION**

FEB 12 1998

SECTION

**LAND CORNER RECORDATION CERTIFICATE
Filing Requirement of Act 74, Mich. P.A. 1970**

For corners in

Osceola

(County)

Located In:

Corner Code #

1. Public Land Survey

T17N R9W I-1

T R

T R

T R

2. Property Controlling
in Section

S T R

S T R

3. Miscellaneous
Property in Sec.

S T R

S T R

APPROVED LAND CORNER
P.A. 245 OF 1990
Osceola County

6 NOV 1997
Matthew M. Clung

Register of Deeds Stamp & File Number

4. Lot No. _____, Recorded Plat _____

5. Private Claims _____

1	A	B	C	D	E	F	G	H	I	J	K	L	M
2	6		5		4		3		2		1		
3													
4	7		8		9		10		11		12		
5													
6	18		17		16		15		14		13		
7													
8	19		20		21		22		23		24		
9													
10	30		29		28		27		26		25		
11													
12	31		32		33		34		35		36		
13													

I, Matthew McClung in a field survey on Oct. 7, 1996 do hereby state that under requirements of P.A. 74, Michigan P.A. of 1970, the corner points mentioned in lines 1 and 2 above were in conformance with regulations and rules therefore as required in the current manual of survey instructions of the United States Department of the Interior, Bureau of Land Management or by a decree of a Court of Law and /or that the corner points mentioned in lines 3, 4 and 5 above were in conformance with the rules of the Michigan Board of Land Surveyors or by a Decree of a Court of Law; established, re-established, monumented, recovered, found as expressed below:

NOTE: Not more than 2 corners, all in the same town and range, may be recorded on this certificate.


A. Description of original monument and accessories and/or subsequent restoration: John Hodgson on June 10, 1838 Set wood post 79.70 chains from the South.
Beech 8" S54W 32 Lks.
Beech 7" S7E 53 Lks.

B. Description of corner evidence found and/or method applied in restoring or reestablishing corner:

Found M.D.N.R. Monument 3" above surface. Corner is marked Sec.s 2 & 3 T17N-R9W Hersey Township. The DNR established this corner and the Osceola County Peer Group approved same. Unwritten history of the remonumentation program, about 1900, indicates this corner should be the tile corner. The DNR in doing State Project No. 75-44, found remains of Pine Stump South 233.0' (same as GLO) is reason peer group accepted corner.

C. Description of monument for corner and accessories established to perpetuate locating the position of the corner:

Corner I-1. is a DNR cap on a 1" pipe, marked Corner Sec.s 2 & 3 Township of Hersey.
1" R. Oak N26W 15.05 feet.
North 34.55' Nail & LSC Tag#21567 in West face, 4" Maple
N20E 28.0' Nail & LSC Tag#21567 in West Face, w/blaze, 1 1/2" Poplar
West 44.20' Fd. Std. DNR Pipe W/cap At SE Cor. Sec. 34, T18N-R9W
Cedar Witness post is down.

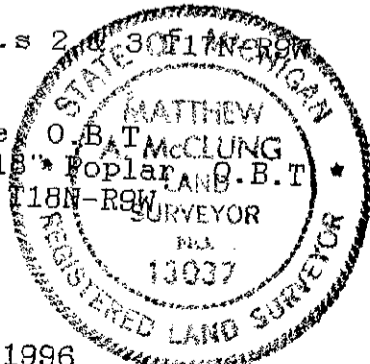

Signed by Matthew M. Clung
Surveyor's Michigan License No. 13037

Date Oct 7, 1996

SURVEY &
REMONUMENTATION

FEB 12 1998

SECTION

OSCEOLA COUNTY
REGISTER OF DEEDS

97 DEC 11 PM 2:10

Nancy Crawford

L.C.R.C. Liber 2, Page 6.
Dated 16 Dec. 1977, by Ostling.
Set Corner U.S. record measure easterly of Standard Corner. No other evidence.
Set DNR Monument and Cedar post.
10" Maple S50E 23.7
4" Maple S45W 33.0
E & W random Due N 17
SE Cor. Sec 34 T18N-R9W Due W 44.4

L.C.R.C. Liber 3, page 66 by Fokens.
I-1 NE Cor. Sec. 3, Fd. Standard DNR 1" pipe w/cap.
North 34.55' Nail & LSC Tag#21567 in West Face 4" Maple.
N20E 28.0' Nail & LSC Tag#21567 in W. face W/blaze 18" Poplar.
West 44.78' Fd. Std. DNR pipe W/cap @ SE Cor Sec. 34, T18N-R9W.

Act 132 Liber 562, pages 654, 655, & 656, by Fokens.

Map of State Project No. 75-44.