

FEB 25 1994

COMMISSION

LAND CORNER RECORDATION CERTIFICATE
Filing Requirement of Act 74, Mich. P.A. 1970

For corners in

<u>Osceola</u> <small>(County)</small>	Located In:	Corner Code =#
	17N 9W	K-11
1. Public Land Survey	T _____ R _____	_____
	T _____ R _____	_____
	T _____ R _____	_____
	T _____ R _____	_____
2. Property Controlling in Section	S _____ T _____ R _____	_____
	S _____ T _____ R _____	_____
3. Miscellaneous Property in Sec.	S _____ T _____ R _____	_____
	S _____ T _____ R _____	_____
4. Lot No. _____, Recorded Plat _____		
5. Private Claims _____		

APPROVED LAND CORNER
P.A. 345 OF 1990
Osceola County

Matthew McClung
8 Dec. 1993


Register of Deeds Stamp & File Number

	A	B	C	D	E	F	G	H	I	J	K	L	M
2	6	5	4	3	2	1							
3													
4	7	8	9	10	11	12							
5													
6	18	17	16	15	14	13							
7													
8	19	20	21	22	23	24							
9													
10	30	29	28	27	26	25							
11													
12	31	32	33	34	35	36							
13													

I, Matthew McClung, in a field survey on December 1, 1993, do hereby certify that under requirements of P.A. 74, Michigan P.A. of 1970, the corner points mentioned in lines 1 and 2 above were in conformance with regulations and rules therefore as required in the current manual of survey instructions of the United States Department of the Interior, Bureau of Land Management or by a decree of a Court of Law and/or that the corner points mentioned in lines 3, 4 and 5 above were in conformance with the rules of the Michigan Board of Land Surveyors or by a Decree of a Court of Law; established, re-established, monumented, re-monumented, recovered, found as expressed below:

NOTE: Not more than 4 corners, all in the same town and range, may be recorded on this certificate.

- A. Description of original monument and accessories and/or subsequent restoration:
The original corner was set by deputy surveyor John Hodgson on June 10, 1838. Set wood post 80.00 chains from the Southwest Corner of Section 36.
Beech 14" N34W 12 lks.
Beech 14" S68W 19 lks.
From 1891 to 1904 approximately, Osceola County had a remonumentation program, in which surveyors Temple and Trumbull, did the work. For the most part, a 3" glazed tile filled with cinders from a forge, were placed at each government set corner in the township. There were supposed to be 3 tile per corner, placed atop of each other, (continued on back)
- B. Description of corner evidence found and/or method applied in restoring or reestablishing corner:
Found 5/8" iron rod and tile at surface, 0.5 feet Southwest of corner fence post. Set Osceola County Monument over 5/8" rod in center of clay tile, 4" above ground.
- C. Description of monument for corner and accessories established to perpetuate locating the position of the corner:
Corner K-11. Osceola County Monument, which is a 3" brass cap mounted on 1" pipe 18" in length.
22" W. Pine N40W 42.7 feet.
12" Hemlock S55W 50.1 feet.
3" Red Oak N39E 25.20 feet.
3" R. Oak N68E 19.70 feet.

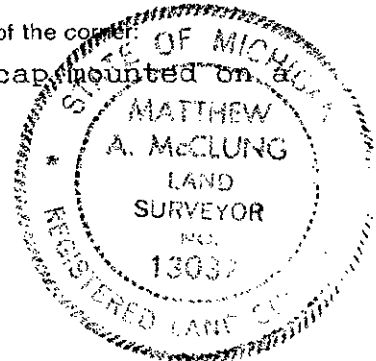

Signed by *Matthew McClung* Date November 6, 1993
Surveyor's Michigan License No. 13037

OSCEOLA COUNTY
REGISTER OF DEEDS

93 DEC 10 PM 2:49

Nancy Crawford

thereby making the corner 4 feet long. Sometimes a solid tile, with a cross in the top was used, and sometimes a 1/2" iron bars were added to the tile. Notes of the work were kept in ledgers, and given to the townships, and 5 of the townships have been recorded in the County records.