

**SURVEY &  
REMONUMENTATION**

**FEB 12 1998**

**LAND CORNER RECORDATION CERTIFICATE  
Filing Requirement of Act 74, Mich. P.A. 1970**

**SECTION**

For corners in

Osceola  
(County)

Located In:

Corner Code #

- |                                       |  |            |
|---------------------------------------|--|------------|
| 1. Public Land Survey                 | T <u>17</u> N <u>R</u> <u>9W</u>       | <u>L-1</u> |
|                                       | T <u>   </u> R <u>   </u>              | <u>   </u> |
|                                       | T <u>   </u> R <u>   </u>              | <u>   </u> |
|                                       | T <u>   </u> R <u>   </u>              | <u>   </u> |
| 2. Property Controlling<br>in Section | S <u>   </u> T <u>   </u> R <u>   </u> | <u>   </u> |
|                                       | S <u>   </u> T <u>   </u> R <u>   </u> | <u>   </u> |
| 3. Miscellaneous<br>Property in Sec.  | S <u>   </u> T <u>   </u> R <u>   </u> | <u>   </u> |
|                                       | S <u>   </u> T <u>   </u> R <u>   </u> | <u>   </u> |

APPROVED LAND CORNER  
P.A. 74 OF 1970  
Osceola County

*16 Oct. 1997*  
*Matthew McClung*

Register of Deeds Stamp & File Number

4. Lot No. \_\_\_\_\_, Recorded Plat \_\_\_\_\_  
5. Private Claims \_\_\_\_\_

I, Matthew McClung in a field survey on Oct 7, 1997 do hereby state that under requirements of P.A. 74, Michigan P.A. of 1970, the corner points mentioned in lines 1 and 2 above were in conformance with regulations and rules therefore as required in the current manual of survey instructions of the United States Department of the Interior, Bureau of Land Management or by a decree of a Court of Law and/or that the corner points mentioned in lines 3, 4 and 5 above were in conformance with the rules of the Michigan Board of Land Surveyors or by a Decree of a Court of Law; established, re-established, monumented, recovered, found as expressed below:

NOTE: Not more than 2 corners, all in the same town and range, may be recorded on this certificate.

	A	B	C	D	E	F	G	H	I	J	K	L	M
1													
2	6		5		4		3		2		1		
3													
4	7		8		9		10		11		12		
5													
6	18		17		16		15		14		13		
7													
8	19		20		21		22		23		24		
9													
10	30		29		28		27		26		25		
11													
12	31		32		33		34		35		36		
13													

A. Description of original monument and accessories and/or subsequent restoration:


From 1891 to 1904 approximately, Osceola County had a remonumentation program, in which surveyors Temple and Trumbull, did the work. For the most part, a 3" glazed tile filled with cinders from a forge, were placed at each government set corner in the township. There were supposed to be 3 tile per corner, placed atop of each other, (continued on back)

B. Description of corner evidence found and/or method applied in restoring or reestablishing corner:

Found 5/8" iron in center of tile, accompanied by down cedar post at ground surface. Placed Osceola County Monument over 5/8" iron in center of tile 3" above surface. Added casonite marker by State of Michigan.

C. Description of monument for corner and accessories established to perpetuate locating the position of the corner:

Corner L-1. Osceola County Monument, which is a 3" brass cap mounted on a 1" pipe 30" in length.  
32" R. Oak S15W 54.8 feet. O.B.T.  
10" Maple West 32.55 feet.  
8" W. Oak N45W 33.6 feet.  
West Most Maple in Clump of 5 N82E 16.4 feet.  
Casonite marker by State of Michigan

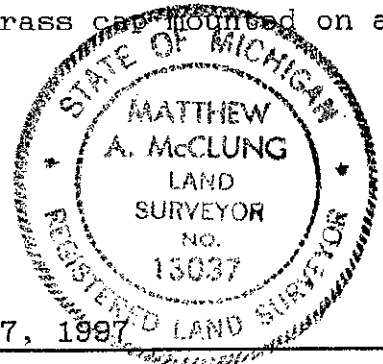

Signed by Matthew M. McClung  
Surveyor's Michigan License No. 13037

Date Oct 7, 1997

SURVEY &  
REMONUMENTATION

FEB 12 1998

SECTION

OSCEOLA COUNTY  
REGISTER OF DEEDS

97 DEC 11 PM 2:10

*Nancy Crawford*

thereby making the corner 4 feet long. Sometimes a solid tile, with a cross in the top was used, and sometimes a 1/2" iron bars were added to the tile. Notes of the work were kept in ledgers, and given to the townships, and 5 of the townships have been entered in the County surveyors records.

I have shown 2 L.C.R.C.; Liber 1 Page 385; Liber 1, Page 400.