

SURVEY & REMONUMENTATION

NOV 01 1999

LAND CORNER RECORDATION CERTIFICATE
Filing Requirement of Act 74, Mich. P.A. 1970

SECTION

For corners in

Osceola

(County)

Located In:

Corner Code #

1. Public Land Survey

T 17R 9W L-6

T ___ R ___

T ___ R ___

T ___ R ___

2. Property Controlling in Section

S ___ T ___ R ___

S ___ T ___ R ___

3. Miscellaneous Property in Sec.

S ___ T ___ R ___

S ___ T ___ R ___

APPROVED LAND CORNER
P.A. 345 OF 1990
Osceola County

Matthew A. McClung
17 May 1999

Register of Deeds Stamp & File Number

4. Lot No. _____, Recorded Plat _____

5. Private Claims _____

I, Matthew McClung in a field survey on 11-4, 1998 do hereby state that under requirements of P.A. 74, Michigan P.A. of 1970, the corner points mentioned in lines 1 and 2 above were in conformance with regulations and rules therefore as required in the current manual of survey instructions of the United States Department of the Interior, Bureau of Land Management or by a decree of a Court of Law and for that the corner points mentioned in lines 3, 4 and 5 above were in conformance with the rules of the Michigan Board of Land Surveyors or by a Decree of a Court of Law, established, re-established, monumented, recovered, found as expressed below:

NOTE: Not more than 2 corners, all in the same town and range, may be recorded on this certificate.

	A	B	C	D	E	F	G	H	I	J	K	L	M
1													
2	6		5		4		3		2		1		
3													
4	7		8		9		10		11		12		
5													
6	18		17		16		15		14		13		
7													
8	19		20		21		22		23		24		
9													
10	30		29		28		27		26		25		
11													
12	31		32		33		34		35		36		
13													

A. Description of original monument and accessories and/or subsequent restoration:
Act 132, Liber 352, page 563. Batzer Act 132, Liber 630, pages 819 & 820.
Shows center unset. Shows center of Section 13.
No Witnesses. No Witnesses.

Act 132, Liber 630, pages 821 & 822.
Shows Center of Section 13.
No Witnesses.

B. Description of corner evidence found and/or method applied in restoring or reestablishing corner:

Set Osceola County Monument at intersection of One Quarter Lines. I did a complete break of Section 13, which shows insignificant differences compared to the Batzer survey.


C. Description of monument for corner and accessories established to perpetuate locating the position of the corner:

Corner L-6, is a Osceola County Monument, which is a 3" brass cap mounted on a 1" pipe 30" in length.

- 16" Hemlock N34W 66.0 feet.
- 18" Maple S50E 28.65 feet.
- 20" Beech N62W 22.75 feet.
- 14" Hemlock South 16.55 feet.

Signed by Matthew A. McClung
Surveyor's Michigan License No. 13037

Date May 25, 1999

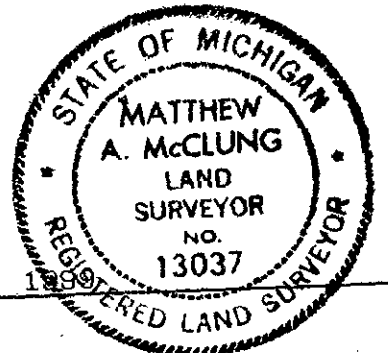

OSCEOLA COUNTY
REGISTER OF DEEDS
99 JUN -4 PM 5:02
James Crawford