

NOV 01 1999

SECTION

LAND CORNER RECORDATION CERTIFICATE
Filing Requirement of Act 74, Mich. P.A. 1970

For corners in Osceola

Located In: Corner Code #

(County)

- 1. Public Land Survey
2. Property Controlling in Section
3. Miscellaneous Property in Sec.

Register of Deeds Stamp & File Number

4. Lot No. , Recorded Plat
5. Private Claims

Robert L. Wetherell, in a field survey on Aug 10, 1999 do hereby state that under requirements of P.A. 74, Michigan P.A. of 1970, the corner points mentioned in lines 1 and 2 above were in conformance with regulations and rules therefore as required in the current manual of survey instructions of the United States Department of the Interior, Bureau of Land Management or by a decree of a Court of Law and for that the corner points mentioned in lines 3, 4 and 5 above were in conformance with the rules of the Michigan Board of Land Surveyors or by a Decree of a Court of Law; established, re-established, monumented, recovered, found as expressed below:

NOTE: Not more than 2 corners, all in the same town and range, may be recorded on this certificate.

L-9 - S 1/4 Corner of Section 24, T17N, R9W

Grid table with columns A-M and rows 1-13. A dot is marked at the intersection of column L and row 9.

A. Description of original monument and accessories and/or subsequent restoration:

1838 - J. Hodgson
#1 12" Hemlock S36E 5 Lks.
#2 8" Hemlock N53W 19 Lks

1891 - 1904 - A. Temple/F.Trumbull
Remonumentation of T17N, R9W
Set 3" Clay tiles

Undated - Hersey Township Book
W 1/2 24 & 25 = 2592.5'
E 1/2 24 & 25 = 2589.5'

(SEE OVER FOR CONTINUATION OF "A")

B. Description of corner evidence found and/or method applied in restoring or reestablishing corner:


Found McClung's Osceola County Monument in North and South Fence line and 4' North of C/L of East and West Road. McClung's measurements were 2588.55' each direction. The road at this corner location has been cut 10'-15' which would have destroyed the clay tile.

Condition of the accessories are as follows: #1 Gone, #2Gone, #3 Found in good condition, #4 Found in good condition, #5 Found in good condition, and #6 Found in good condition.

C. Description of monument for corner and accessories established to perpetuate locating the position of the corner:

I accept the Osceola County Monument (1 1/2" pipe with Osceola Remon Cap) as a substantial marker for the corner, and I accept it as a careful and faithful reestablishment of the position of the original corner.

- Corner Post (Nail in E. side) N06W 35.13' #3
3" W. Pine (Nail in W. side) S24W 34.75' #4
12" Aspen (Nail in SE side) N60E 48.54' # 6
6" R. Pine (Nail in W. side) S35E 55.95'

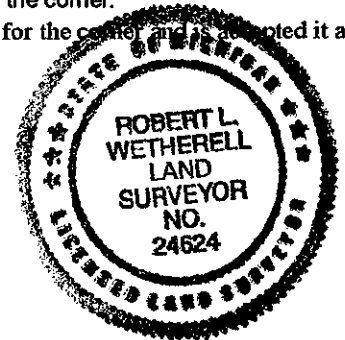

Signed by Robert L. Wetherell
Surveyor's Michigan License No. 24624

Date 8-26-99

APPROVED LAND CORNER
P.A. 345 OF 1990
Osceola County

8-26-99
R P 111

CONTINUATION OF DESCRIPTION OF ORIGINAL MONUMENT AND ACCESSORIES AND/OR SUBSEQUENT RETORATION.

1998- McClung LS 13037

Survey Record

L.650, Pg. 528

Set Osceola Co. Monument by single proportionate method.

#3 - Cor. Post N6W 35.1'

#4 - 3" W. Pine S24W 34.7'

#5 - 5" Birch S15E 31.55'

#6 - 12" Aspen N60E 48.50'

Nancy Campbell

OSCEOLA COUNTY
REGISTER OF DEEDS
99 SEP -3 AM 11:48

SURVEY &
REMONUMENTATION

NOV 01 1999

SECTION