

**SURVEY & REMONUMENTATION**

FEB 12 1998

**SECTION**

**LAND CORNER RECORDATION CERTIFICATE**  
Filing Requirement of Act 74, Mich. P.A. 1970

For corners in

Osceola  
(County)

Located In:

Corner Code #

- |                                    |   |           |   |           |       |
|------------------------------------|---|-----------|---|-----------|-------|
| 1. Public Land Survey              | T | <u>7N</u> | R | <u>9W</u> | L-13  |
|                                    | T | _____     | R | _____     | _____ |
|                                    | T | _____     | R | _____     | _____ |
|                                    | T | _____     | R | _____     | _____ |
| 2. Property Controlling in Section | S | _____     | T | _____     | R     |
|                                    | S | _____     | T | _____     | R     |
| 3. Miscellaneous Property in Sec.  | S | _____     | T | _____     | R     |
|                                    | S | _____     | T | _____     | R     |

APPROVED LAND CORNER  
P.A. 345 OF 1990  
Osceola County  
*16 Oct 1997*  
*Matthew McClung*  
Register of Deeds Stamp & File Number

4. Lot No. \_\_\_\_\_, Recorded Plat \_\_\_\_\_  
5. Private Claims \_\_\_\_\_

I, Matthew McClung, in a field survey on Oct 7, 1997 do hereby state that under requirements of P.A. 74, Michigan P.A. of 1970, the corner points mentioned in lines 1 and 2 above were in conformance with regulations and rules therefore as required in the current manual of survey instructions of the United States Department of the Interior, Bureau of Land Management or by a decree of a Court of Law and /or that the corner points mentioned in lines 3, 4 and 5 above were in conformance with the rules of the Michigan Board of Land Surveyors or by a Decree of a Court of Law; established, re-established, monumented, recovered, found as expressed below:

NOTE: Not more than 2 corners, all in the same town and range, may be recorded on this certificate.


	A	B	C	D	E	F	G	H	I	J	K	L	M
1													
2	6			5			4			3			2
3													
4	7			8			9			10			11
5													
6	18			17			16			15			14
7													
8	19			20			21			22			23
9													
10	30			29			28			27			26
11													
12	31			32			33			34			35
13													36

A. Description of original monument and accessories and/or subsequent restoration:  
The original corner was set by deputy surveyor John Hodgson on 1 November 1837. Set wood post 40.00 chains from East.  
Pine 24" N81E 8 Lks  
Beech 12" N9W 40 Lks  
Found Stump of Government Witness tree N70E 5.85 feet. (4.9' to face)

B. Description of corner evidence found and/or method applied in restoring or reestablishing corner:  
Set Osceola County Monument 3" above surface 12.21 feet West of Hersey Corner. Hersey Corner is Osceola County Monument and tile.

C. Description of monument for corner and accessories established to perpetuate locating the position of the corner:  
Corner F-7. Osceola County Monument, which is a 3" brass cap mounted on a 1" pipe 30" in length.  
10" Maple West 15.85 feet.  
32" R. Oak S10W 48.75 feet.  
8" W. Oak N20W 24.25 feet  
West Most Maple in Clump of 5 N80E 33.00 feet  
GLO witness tree Pine Stump N70E 5.85 feet.

*Harvey Campbell*  
97 DEC 11 PM 2: 10  
OSCEOLA COUNTY REGISTER OF DEEDS

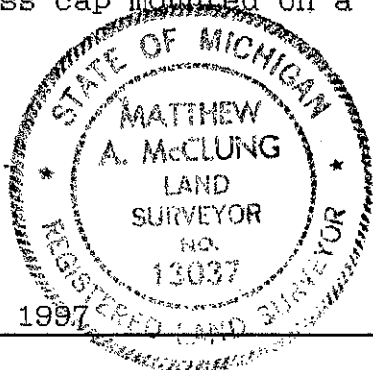

Signed by Matthew McClung  
Surveyor's Michigan License No. 13037

Date Oct. 7, 1997