

**SURVEY & REMONUMENTATION**

**FEB 12 1998**

**SECTION**

**LAND CORNER RECORDATION CERTIFICATE**  
Filing Requirement of Act 74, Mich. P.A. 1970

For corners in

Osceola

(County)

Located In:

Corner Code #

- |                                    |                       |            |
|------------------------------------|-----------------------|------------|
| 1. Public Land Survey              | <u>T7N</u> <u>R9W</u> | <u>M-1</u> |
|                                    | T___ R___             | _____      |
|                                    | T___ R___             | _____      |
|                                    | T___ R___             | _____      |
| 2. Property Controlling in Section | S___ T___ R___        | _____      |
|                                    | S___ T___ R___        | _____      |
| 3. Miscellaneous Property in Sec.  | S___ T___ R___        | _____      |
|                                    | S___ T___ R___        | _____      |

APPROVED LAND CORNER  
P.A. 345 OF 1990  
Osceola County

*16 Oct. 1997*  
*Matthew McClung*

Register of Deeds Stamp & File Number

4. Lot No. \_\_\_\_\_, Recorded Plat \_\_\_\_\_
5. Private Claims \_\_\_\_\_

I, Matthew McClung, in a field survey on Dec 10, 1996 do hereby state that under requirements of P.A. 74, Michigan P.A. of 1970, the corner points mentioned in lines 1 and 2 above were in conformance with regulations and rules therefore as required in the current manual of survey instructions of the United States Department of the Interior, Bureau of Land Management or by a decree of a Court of Law and /or that the corner points mentioned in lines 3, 4 and 5 above were in conformance with the rules of the Michigan Board of Land Surveyors or by a Decree of a Court of Law; established, re-established, monumented, recovered, found as expressed below:

NOTE: Not more than 2 corners, all in the same town and range, may be recorded on this certificate.

	A	B	C	D	E	F	G	H	I	J	K	L	M
1													
2	6		5		4		3		2		1		
3													
4	7		8		9		10		11		12		
5													
6	18		17		16		15		14		13		
7													
8	19		20		21		22		23		24		
9													
10	30		29		28		27		26		25		
11													
12	31		32		33		34		35		36		
13													

A. Description of original monument and accessories and/or subsequent restoration:

The original corner was set by deputy surveyor John Hodgson on November 1, 1837 Set wood post 80.00 chains from the East.  
Sugar 10" N75E 16 lks.  
Hemlock 10" N46W 16 Lks.


From 1891 to 1904 approximately, Osceola County had a remonumentation program, in which surveyors Temple and Trumbull, did the work. For the most part, a 3" glazed tile filled with cinders from a forge, were placed at each government set corner in the township. There were supposed to be 3 tile per corner, placed atop of each other, (continued on back)

B. Description of corner evidence found and/or method applied in restoring or reestablishing corner:

Found M.D.N.R. Monument with pieces of Cap broken off East of 5/8" iron rod in tile, accompanied by D.N.R. cedar post. (State project No. 75-44) Placed 30" Osceola County Monument over 5/8" iron rod in center of tile 4" above surface. Removed D.N.R. monument, as peer group wanted monument in center of tile.

C. Description of monument for corner and accessories established to perpetuate locating the position of the corner:

Corner M-1. Osceola County Monument, which is a 3" brass cap mounted on a 1" pipe 30" in length.  
2" Cherry S6W 8.4 feet.  
2" Maple N15E 4.1 feet.  
3" Maple N60W 20.05 feet.  
4" Cherry N30W 29.40 feet.  
3" Maple N82W 10.85 feet.  
With casonite marker by State.

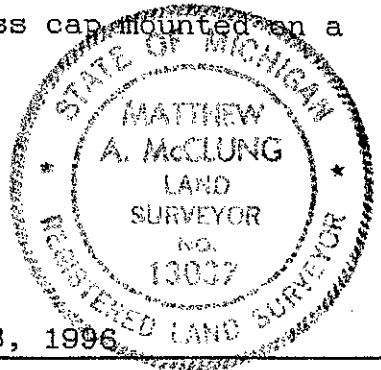

Signed by Matthew McClung  
Surveyor's Michigan License No. 13037

Date July 3, 1996

SURVEY &  
REMONUMENTATION

FEB 12 1998

SECTION

OSCEOLA COUNTY  
REGISTER OF DEEDS

97 DEC 11 PM 2:10

*Nancy Crawford*

thereby making the corner 4 feet long. Sometimes a solid tile, with a cross in the top was used, and sometimes a 1/2" iron bars were added to the tile. Notes of the work were kept in ledgers, and given to the townships, and 5 of the townships have been recorded in the County records.

Map of State Project No. 75-44.