

AUG 27 1996

COMMISSION

LAND CORNER RECORDATION CERTIFICATE  
Filing Requirement of Act 74, Mich. P.A. 1970

For corners in

Osceola		Located In:	Corner Code #
(County)		17N 9W	M-7
1. Public Land Survey	T ___ R ___		
	T ___ R ___		
	T ___ R ___		
	T ___ R ___		
2. Property Controlling In Section	S ___ T ___ R ___		
	S ___ T ___ R ___		
3. Miscellaneous Property in Sec.	S ___ T ___ R ___		
	S ___ T ___ R ___		

APPROVED LAND CORNER  
P.A. 345 OF 1990  
Osceola County

*Matthew McClung*  
25 July 1996

Register of Deeds Stamp & File Number

4. Lot No. \_\_\_\_\_, Recorded Plat \_\_\_\_\_  
5. Private Claims \_\_\_\_\_

(SAME AS T17N, R8W A-07)

I, Matthew McClung in a field survey on July 3<sup>rd</sup> 1996, do hereby certify that under requirements of P.A. 74, Michigan P.A. of 1970, the corner points mentioned in lines 1 and 2 above were in conformance with regulations and rules therefore as required in the current manual of survey instructions of the United States Department of the Interior, Bureau of Land Management or by a decree of a Court of Law and/or that the corner points mentioned in lines 3, 4 and 5 above were in conformance with the rules of the Michigan Board of Land Surveyors or by a Decree of a Court of Law; established, re-established, monumented, re-monumented, recovered, found as expressed below:

**NOTE: Not more than 4 corners, all in the same town and range, may be recorded on this certificate.**

	A	B	C	D	E	F	G	H	I	J	K	L	M
2	6		5		4		3		2		1		
3													
4	7		8		9		10		11		12		
5													
6	18		17		16		15		14		13		
7													
8	19		20		21		22		23		24		
9													
10	30		29		28		27		26		25		
11													
12	31		32		33		34		35		36		
13													

A. Description of original monument and accessories and/or subsequent restoration:

The original corner was set by deputy surveyor John Hodgson on Oct. 30, 1837. Set wood post 80.00 chains from the South.  
Beech 8" N37W 27 lks.  
Beech 7" S31W 21 lks.


From 1891 to 1904 approximately, Osceola County had a remonumentation program, in which surveyors Temple and Trumbull, did the work. For the most part, a 3" glazed tile filled with cinders from a forge, were placed at each government set corner in the township. There were supposed to be 3 tile per corner, placed atop of each other, (continued on back)

B. Description of corner evidence found and/or method applied in restoring or reestablishing corner:

Found 1/2" Iron Bar in tile 8" below surface. Placed Osceola County Monument over 1/2" iron bar in tile 6" below road surface. Corner is in centerline of East and West Road.

C. Description of monument for corner and accessories established to perpetuate locating the position of the corner:

Corner M-7. Osceola County Monument, which is a 3" brass cap mounted on a 1" pipe 18" in length.  
2" R. Pine N22E 45.95 feet.  
6" Thorn Apple N45E 43.44 feet. O.B.P.  
20" Beech N65W 69.40 feet. O.B.P.  
16" Forked Cherry N1W 63.0 feet O.B.P.

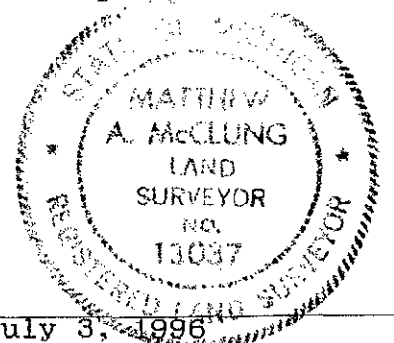

Signed by *Matthew McClung*

Date July 3, 1996

Surveyor's Michigan License No. 13037

OSCEOLA COUNTY  
REGISTER OF DEEDS

96 AUG -7 PM 4: 31

*Nancy Crawford*

thereby making the corner 4 feet long. Sometimes a solid tile, with a cross in the top was used, and sometimes a 1/2" iron bars were added to the tile. Notes of the work were kept in ledgers, and given to the townships, and 5 of the townships have been recorded in the County records.

There is 1 LCRC; Liber 2, page 143

There is 1 PA 132 survey; Liber 352, Page 563.

Hersey Township Records Book Pages 2 and 3.